


101-30

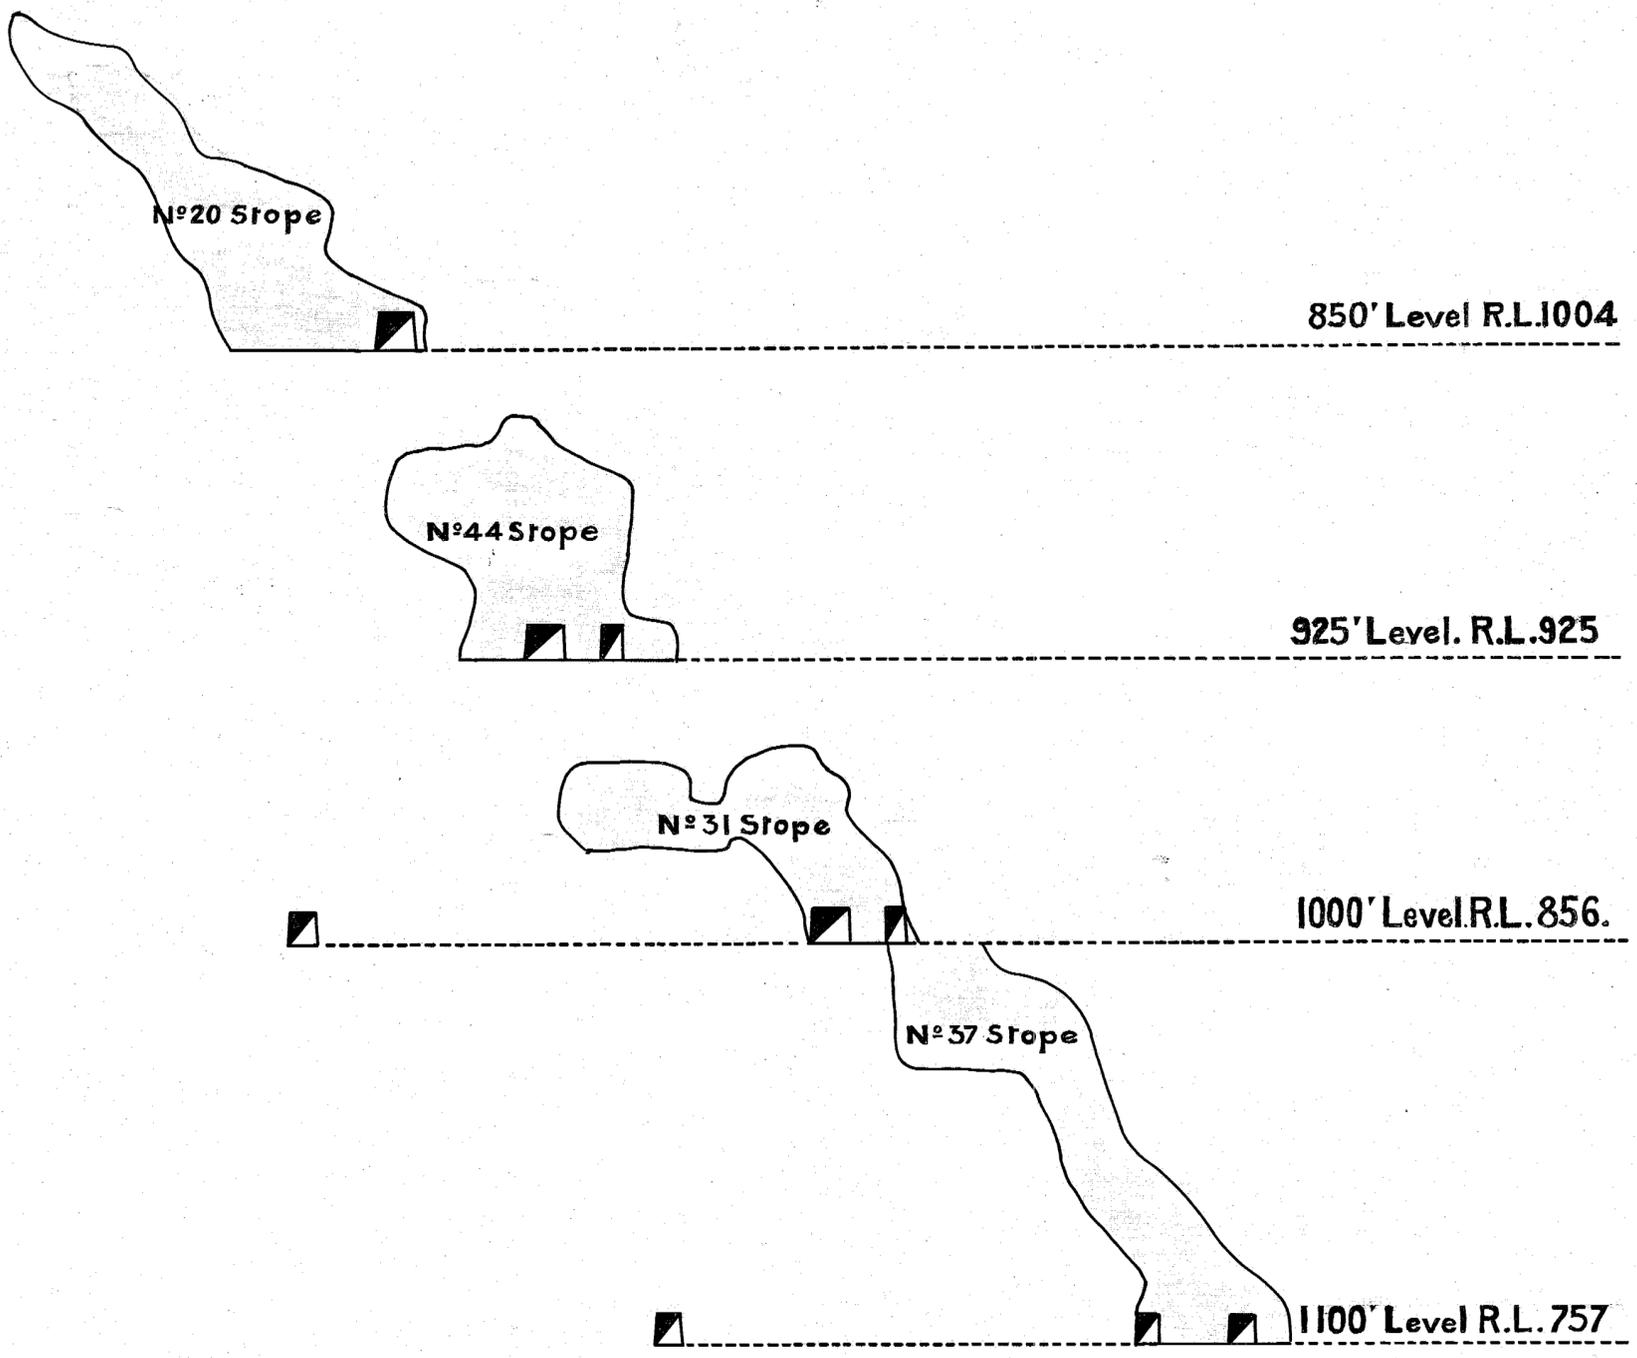

The Mount Lyell Mining & Railway Co., Ltd.

Mine Department

NORTH LYELL MINE Section on Line C C looking North

Brought up to Dec. 31st 1924

Scale 1" = 30'

R. L. Murray General Manager
G. H. Fisher Mine Superintendent