


101-31

5 cm

101-31

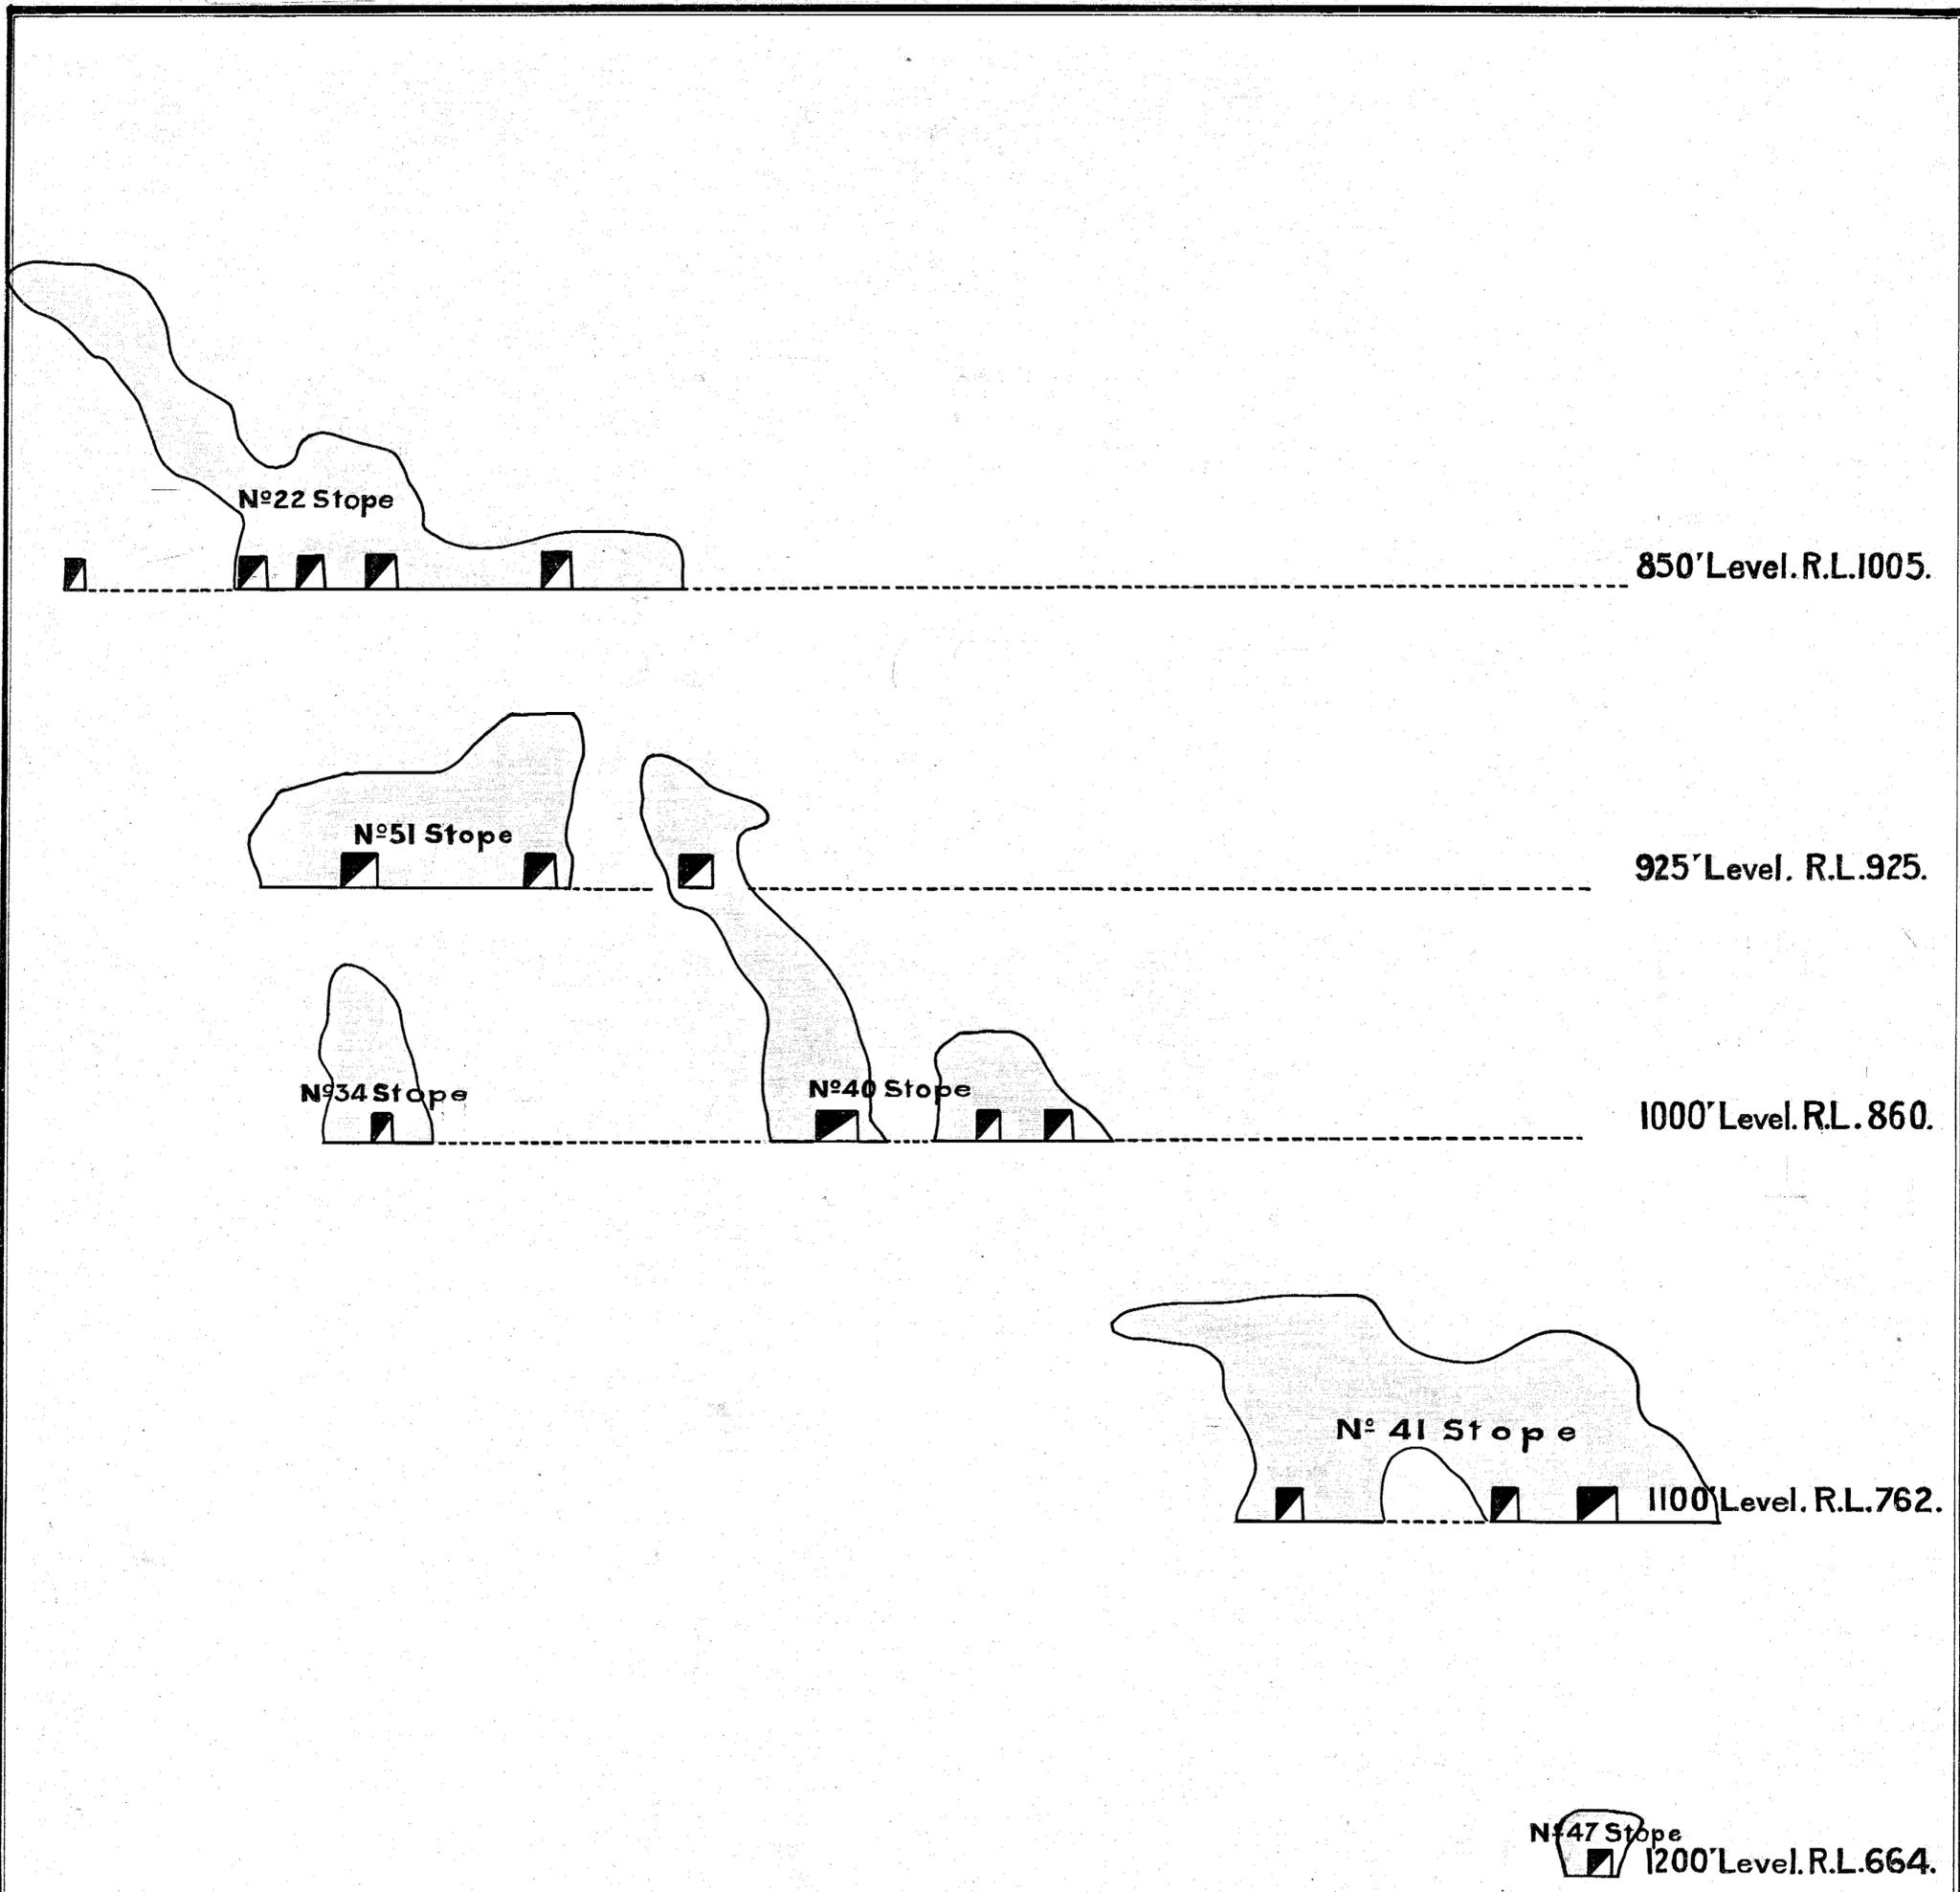

The Mount Lyell Mining & Railway Co., Ltd.

Mine Department

NORTH LYELL MINE

Section on Line DD looking North

Brought up to Dec. 31st 1924

Scale ÷ 1" = 30'

R. Williams General Manager
C. H. Baker Mine Superintendent