


LYELL THARSIS

101-33

5 cm

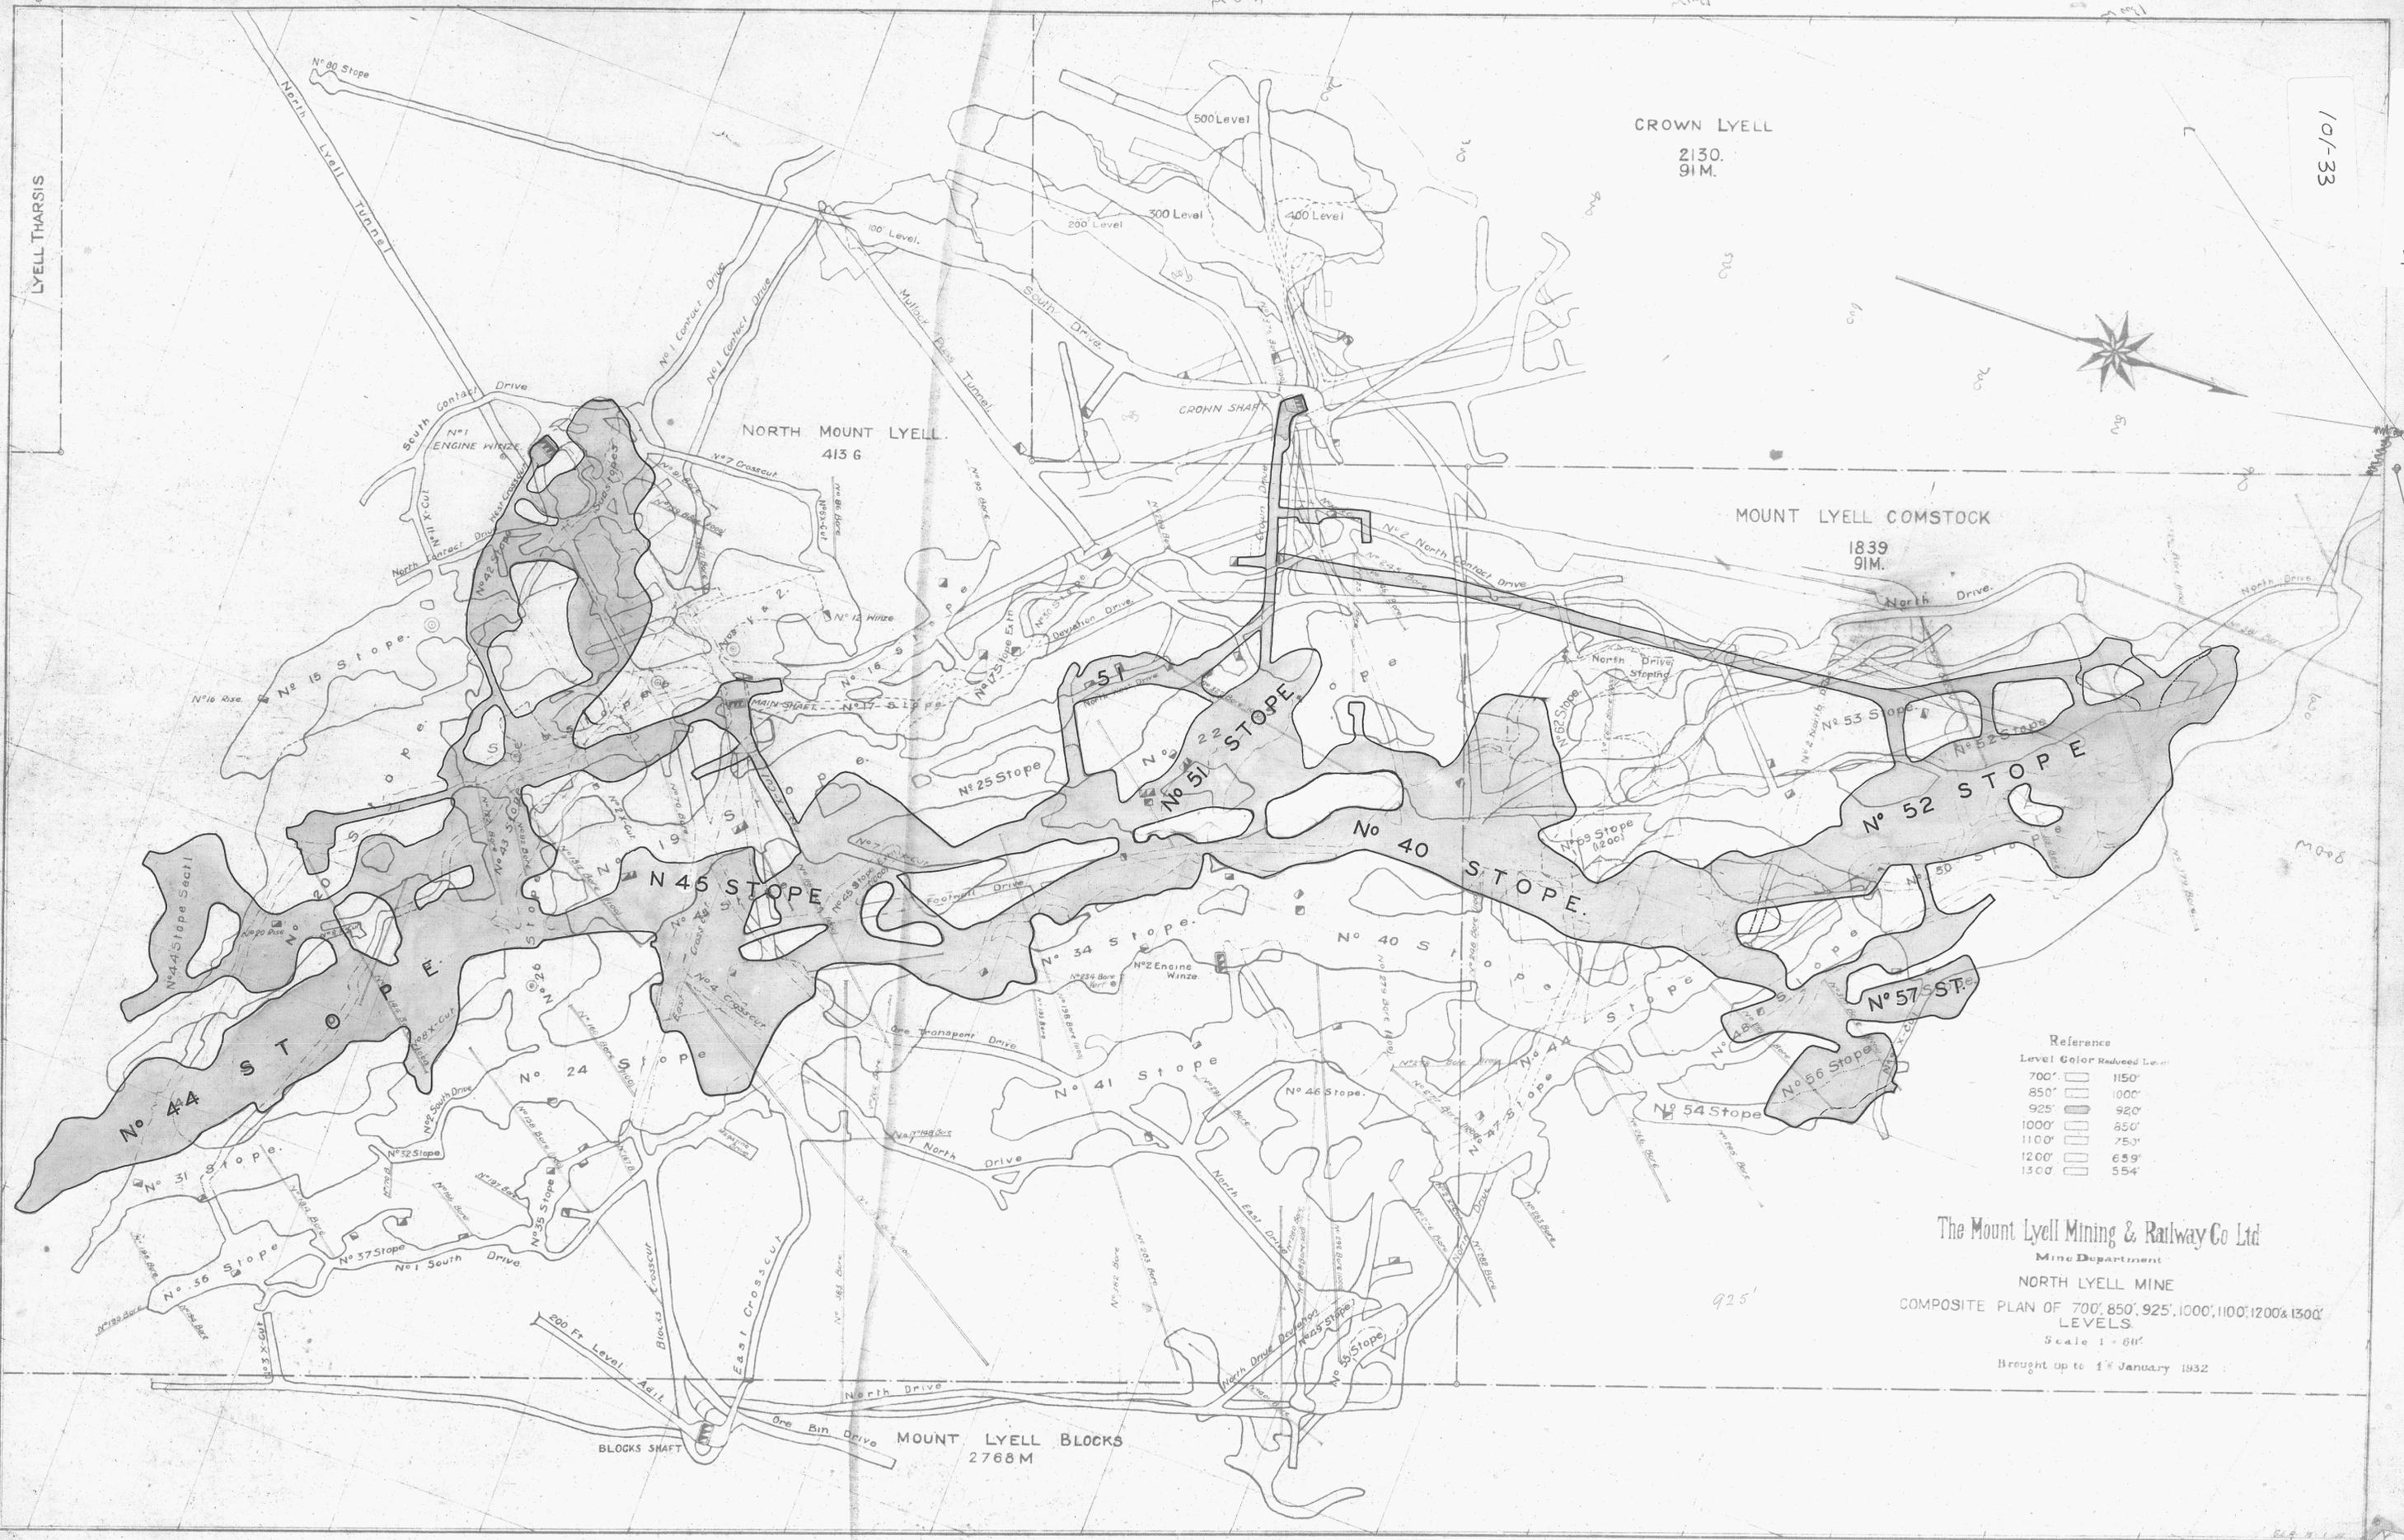

CROWN LYELL
2130.
91M.

NORTH MOUNT LYELL.
413 6

MOUNT LYELL COMSTOCK
1839
91M.

MOUNT LYELL BLOCKS
2768 M

Reference

Level	Color	Reduced Level
700'	[White]	1150'
850'	[Light Grey]	1000'
925'	[Medium Grey]	920'
1000'	[Dark Grey]	850'
1100'	[Black]	750'
1200'	[Dark Grey]	659'
1300'	[Black]	554'

The Mount Lyell Mining & Railway Co Ltd
 Mine Department
 NORTH LYELL MINE
 COMPOSITE PLAN OF 700', 850', 925', 1000', 1100', 1200' & 1300'
 LEVELS.
 Scale 1" = 60'
 Brought up to 1st January 1932