


101-34

101-34

LYELL THARSIS

CROWN LYELL


2130.  
91M.

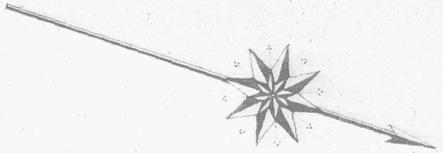

NORTH MOUNT LYELL.  
413 G

MOUNT LYELL COMSTOCK

1839  
91M.

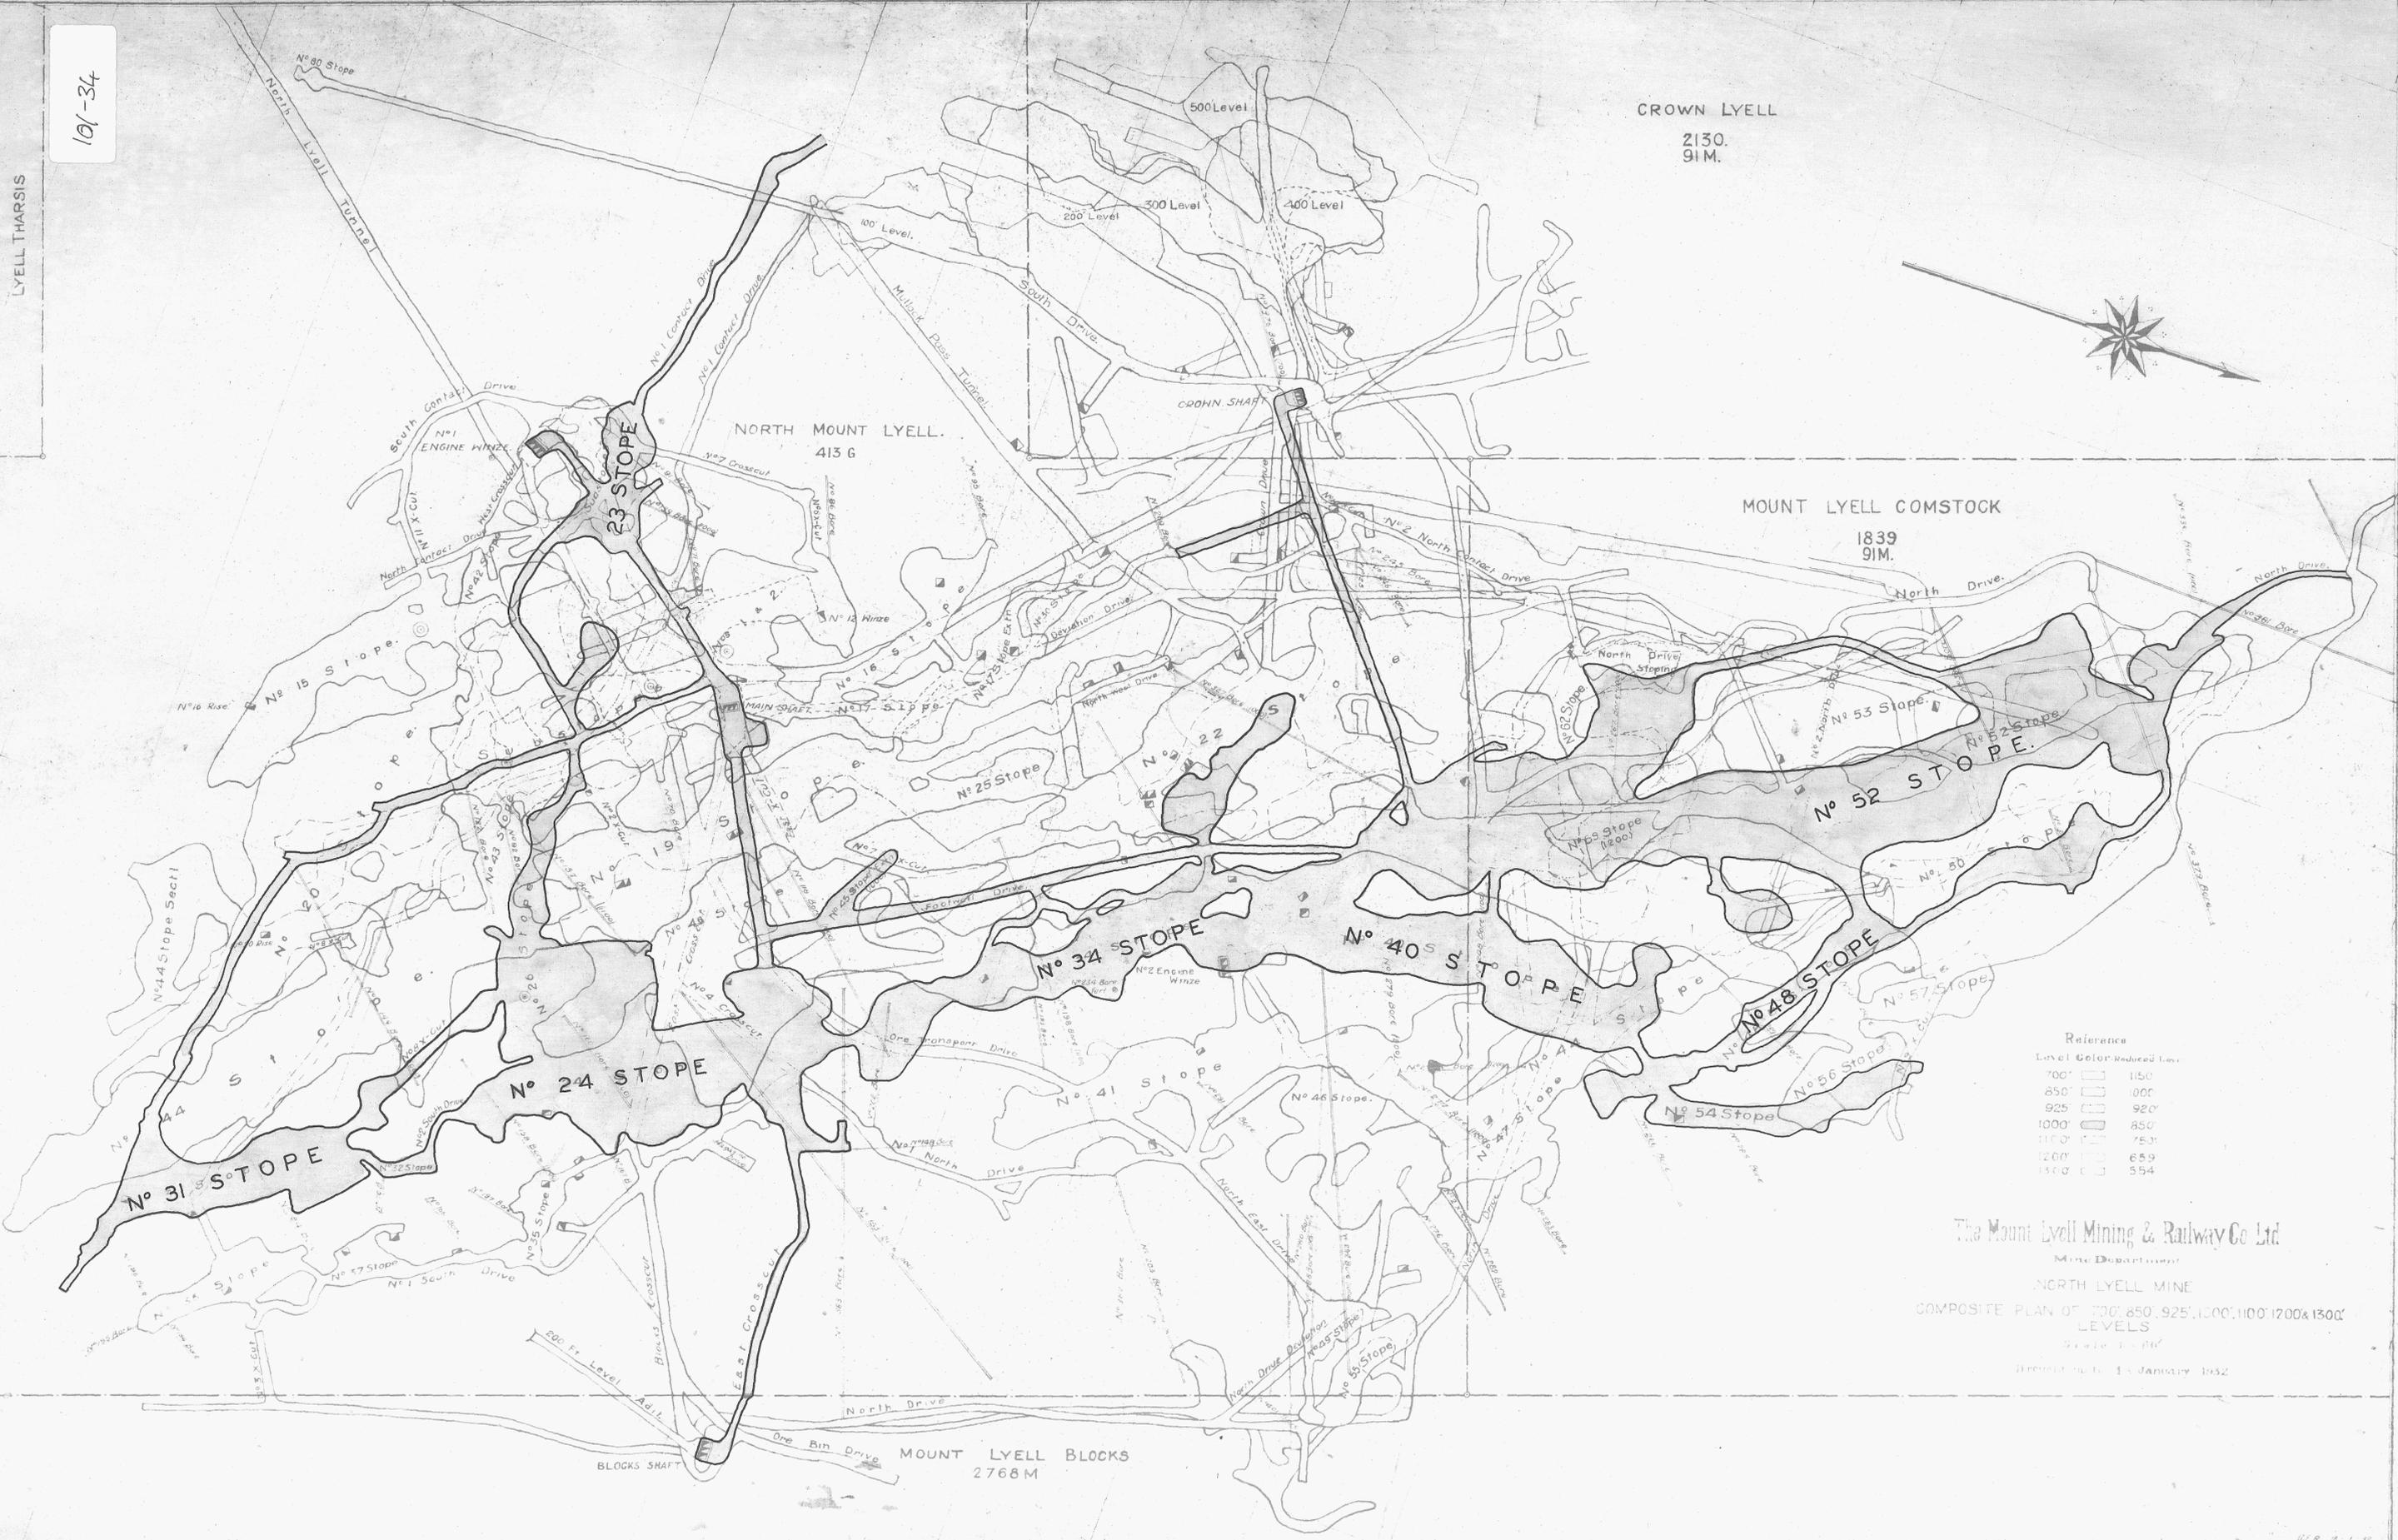

Reference

Level	Color	Reduced Line
700'	[Color swatch]	1150
850'	[Color swatch]	000
925'	[Color swatch]	920
1000'	[Color swatch]	850
1100'	[Color swatch]	750
1200'	[Color swatch]	650
1300'	[Color swatch]	550

The Mount Lyell Mining & Railway Co Ltd

Mine Department

NORTH LYELL MINE

COMPOSITE PLAN OF 700', 850', 925', 1000', 1100', 1200' & 1300' LEVELS

Scale 1" = 60'

Printed on 1st January 1932

MOUNT LYELL BLOCKS  
2768 M

