

101-37

50m


LYELL THARSIS

CROWN LYELL  
2130  
91M.

NORTH MOUNT LYELL.  
415 G

MOUNT LYELL COMSTOCK  
1839  
91M.

MOUNT LYELL BLOCKS  
2768 M

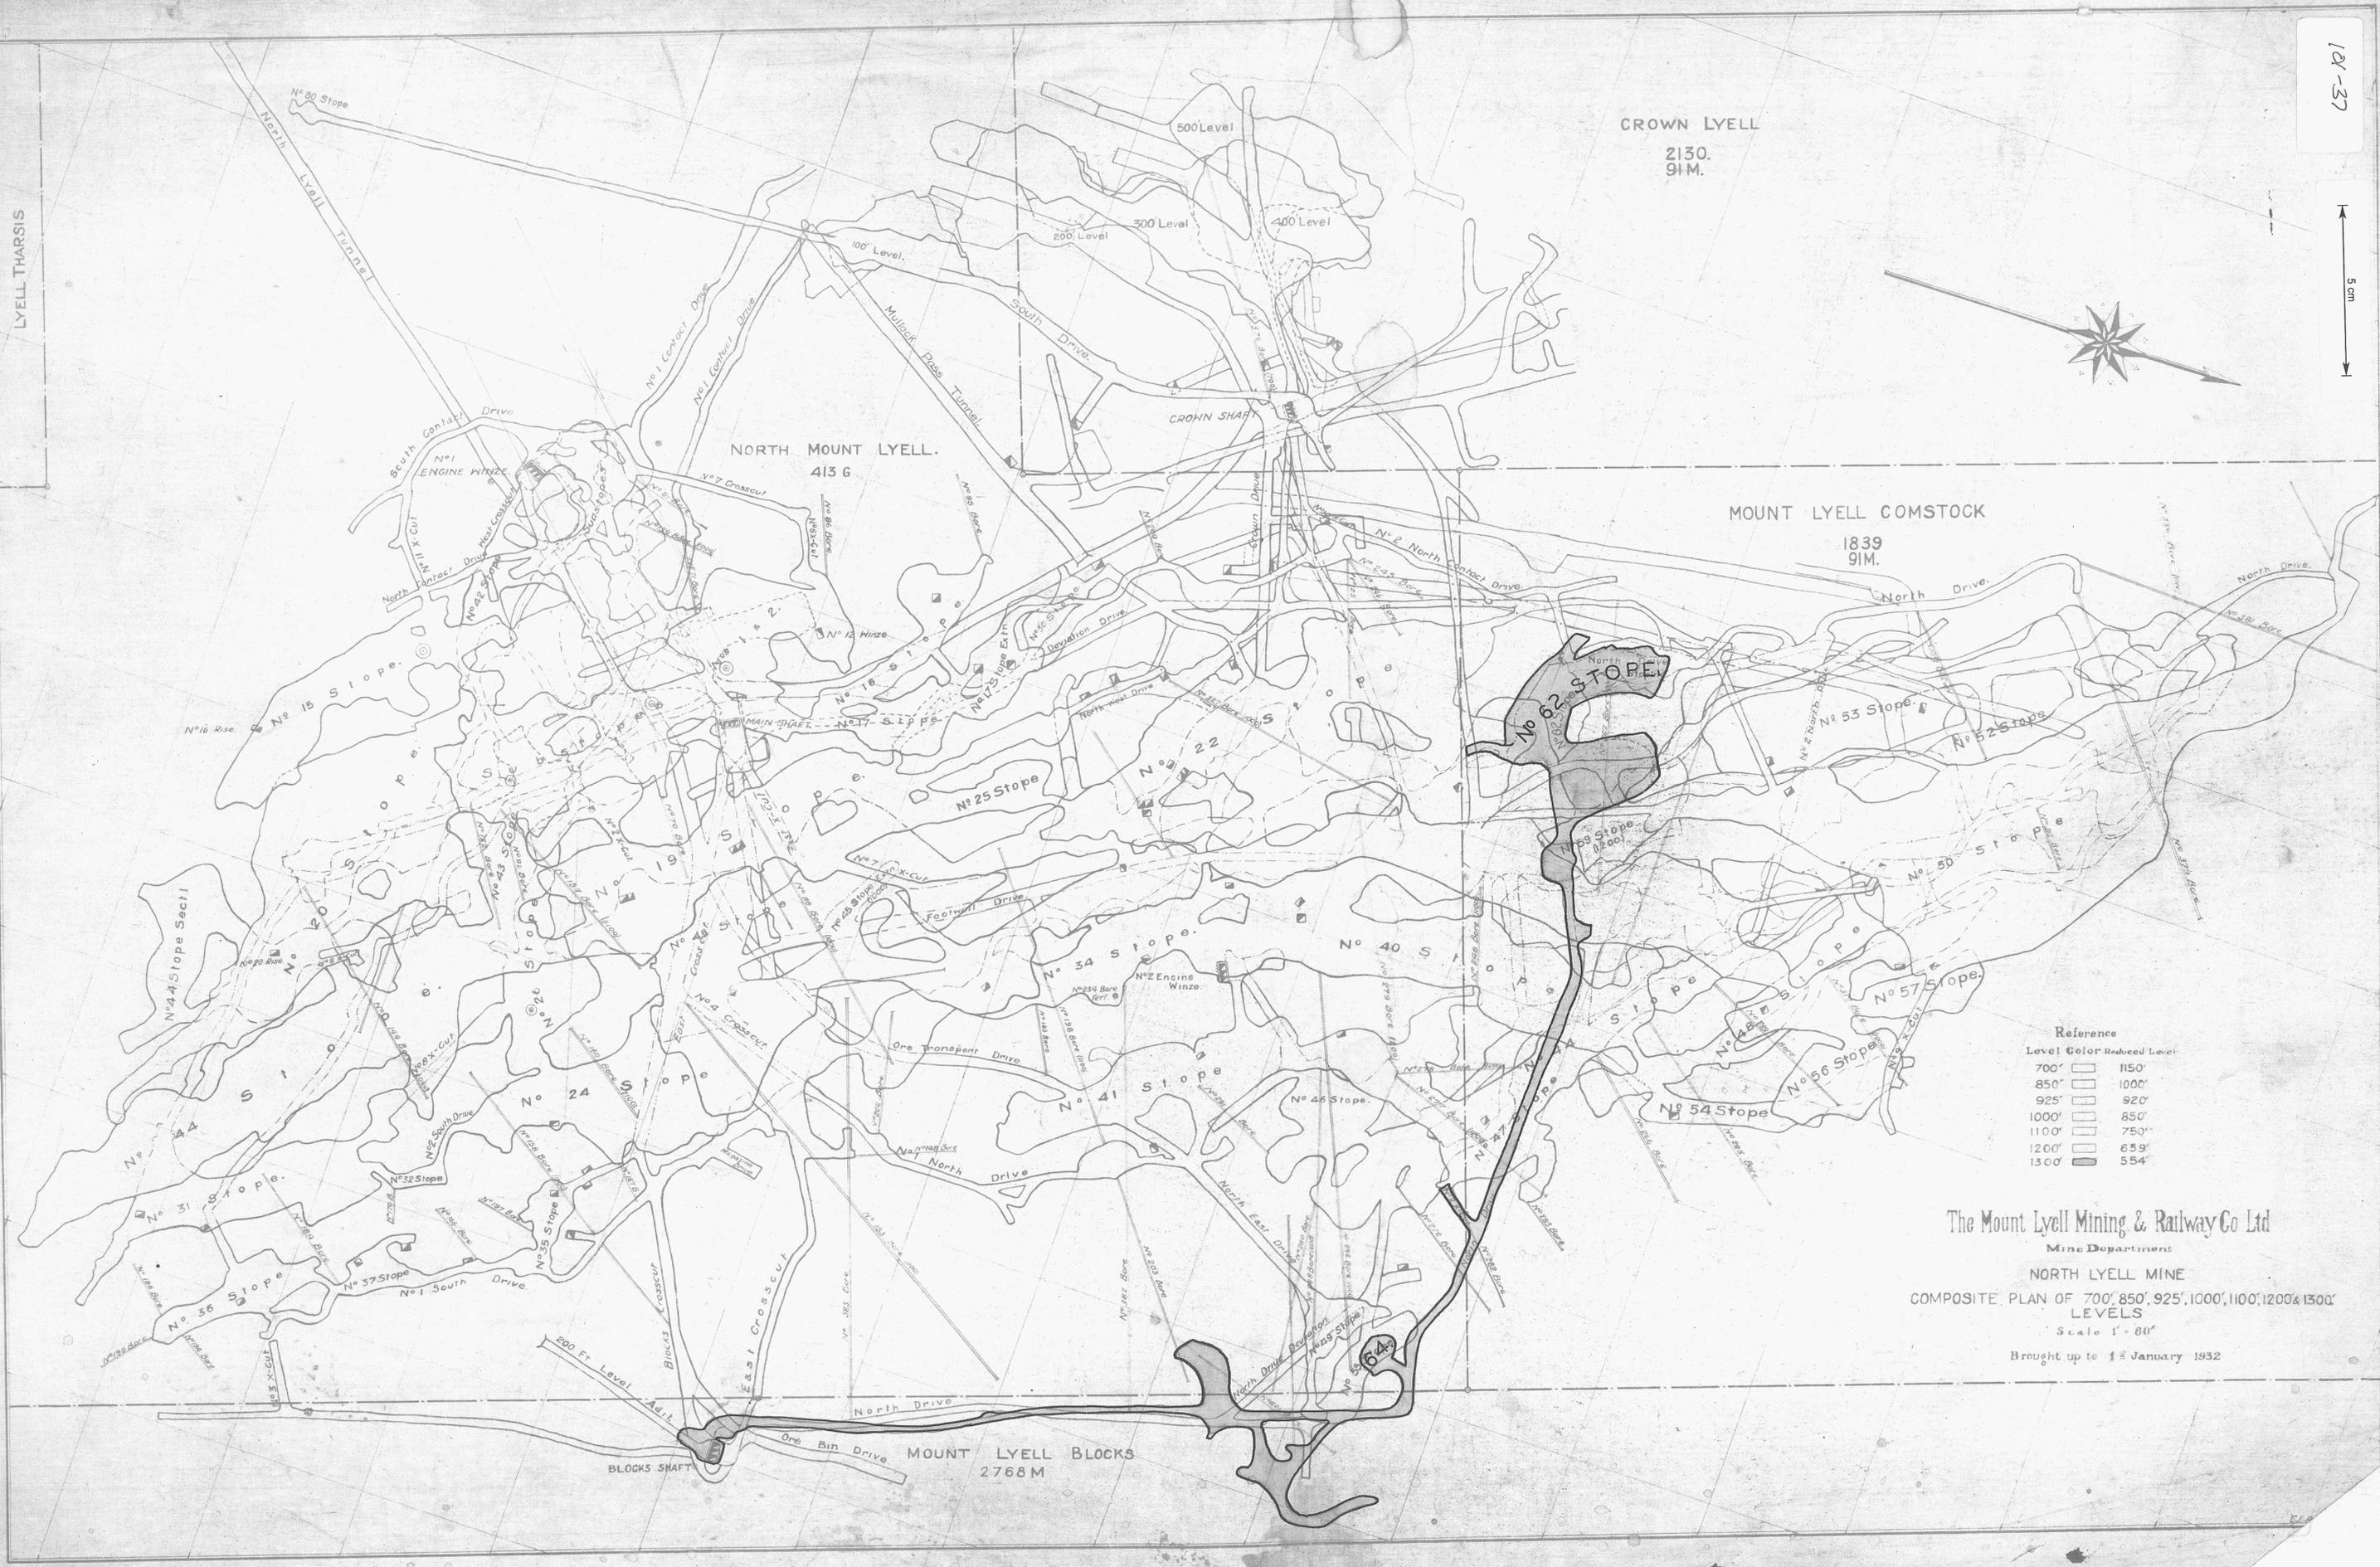

Reference

Level	Color	Reduced Level
700'	[White]	1150'
850'	[Light Grey]	1000'
925'	[Medium Grey]	920'
1000'	[Dark Grey]	850'
1100'	[Black]	750'
1200'	[Dark Grey]	659'
1300'	[Black]	554'

The Mount Lyell Mining & Railway Co Ltd  
 Mine Department  
 NORTH LYELL MINE  
 COMPOSITE PLAN OF 700', 850', 925', 1000', 1100', 1200' & 1300'  
 LEVELS  
 Scale 1" = 80'  
 Brought up to 1st January 1932

101-37