

5 cm

Dept. of Mines 0091
Plan
1899


103-01

- CROWN LYELL MINING CO -

- Underground Survey 1899 -

- Scale 25 Feet to an Inch -

John P. Jones
Authorized Surveyor
April 1900

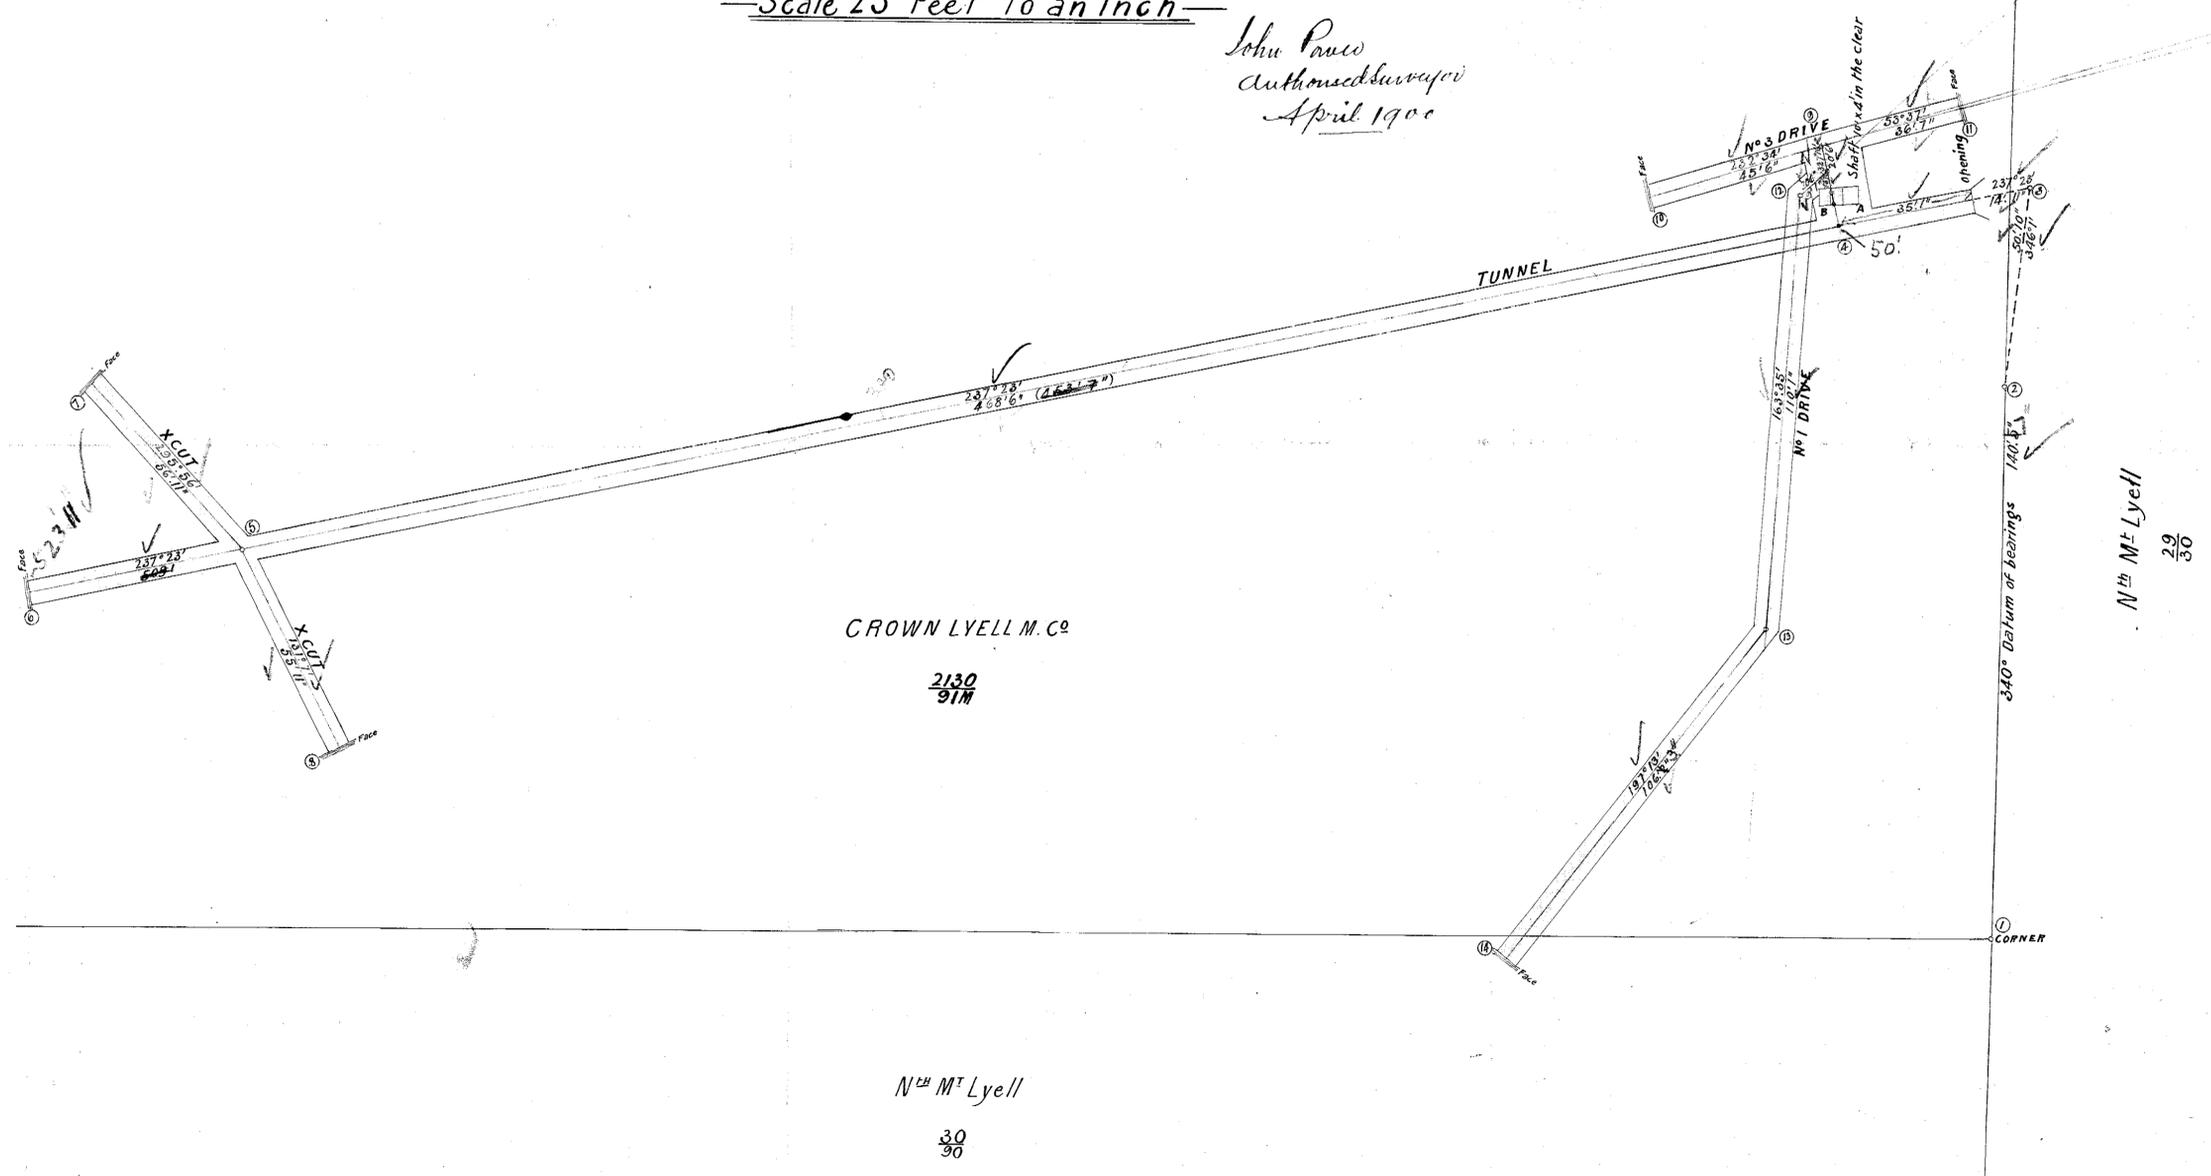

CROWN LYELL M. CO

2130
91M

Nth M^r Lyell

30
30

Nth M^r Lyell
29
30

for 1899
Crown Lyell M. Co

42