

5 cm


1900 Crown Lyell Mining Co. Plans

- Crown Lyell Mining Co -

- Section -

- Scale - 25 Feet to an Inch -

John P. New
Authorized Surveyor
April 1900

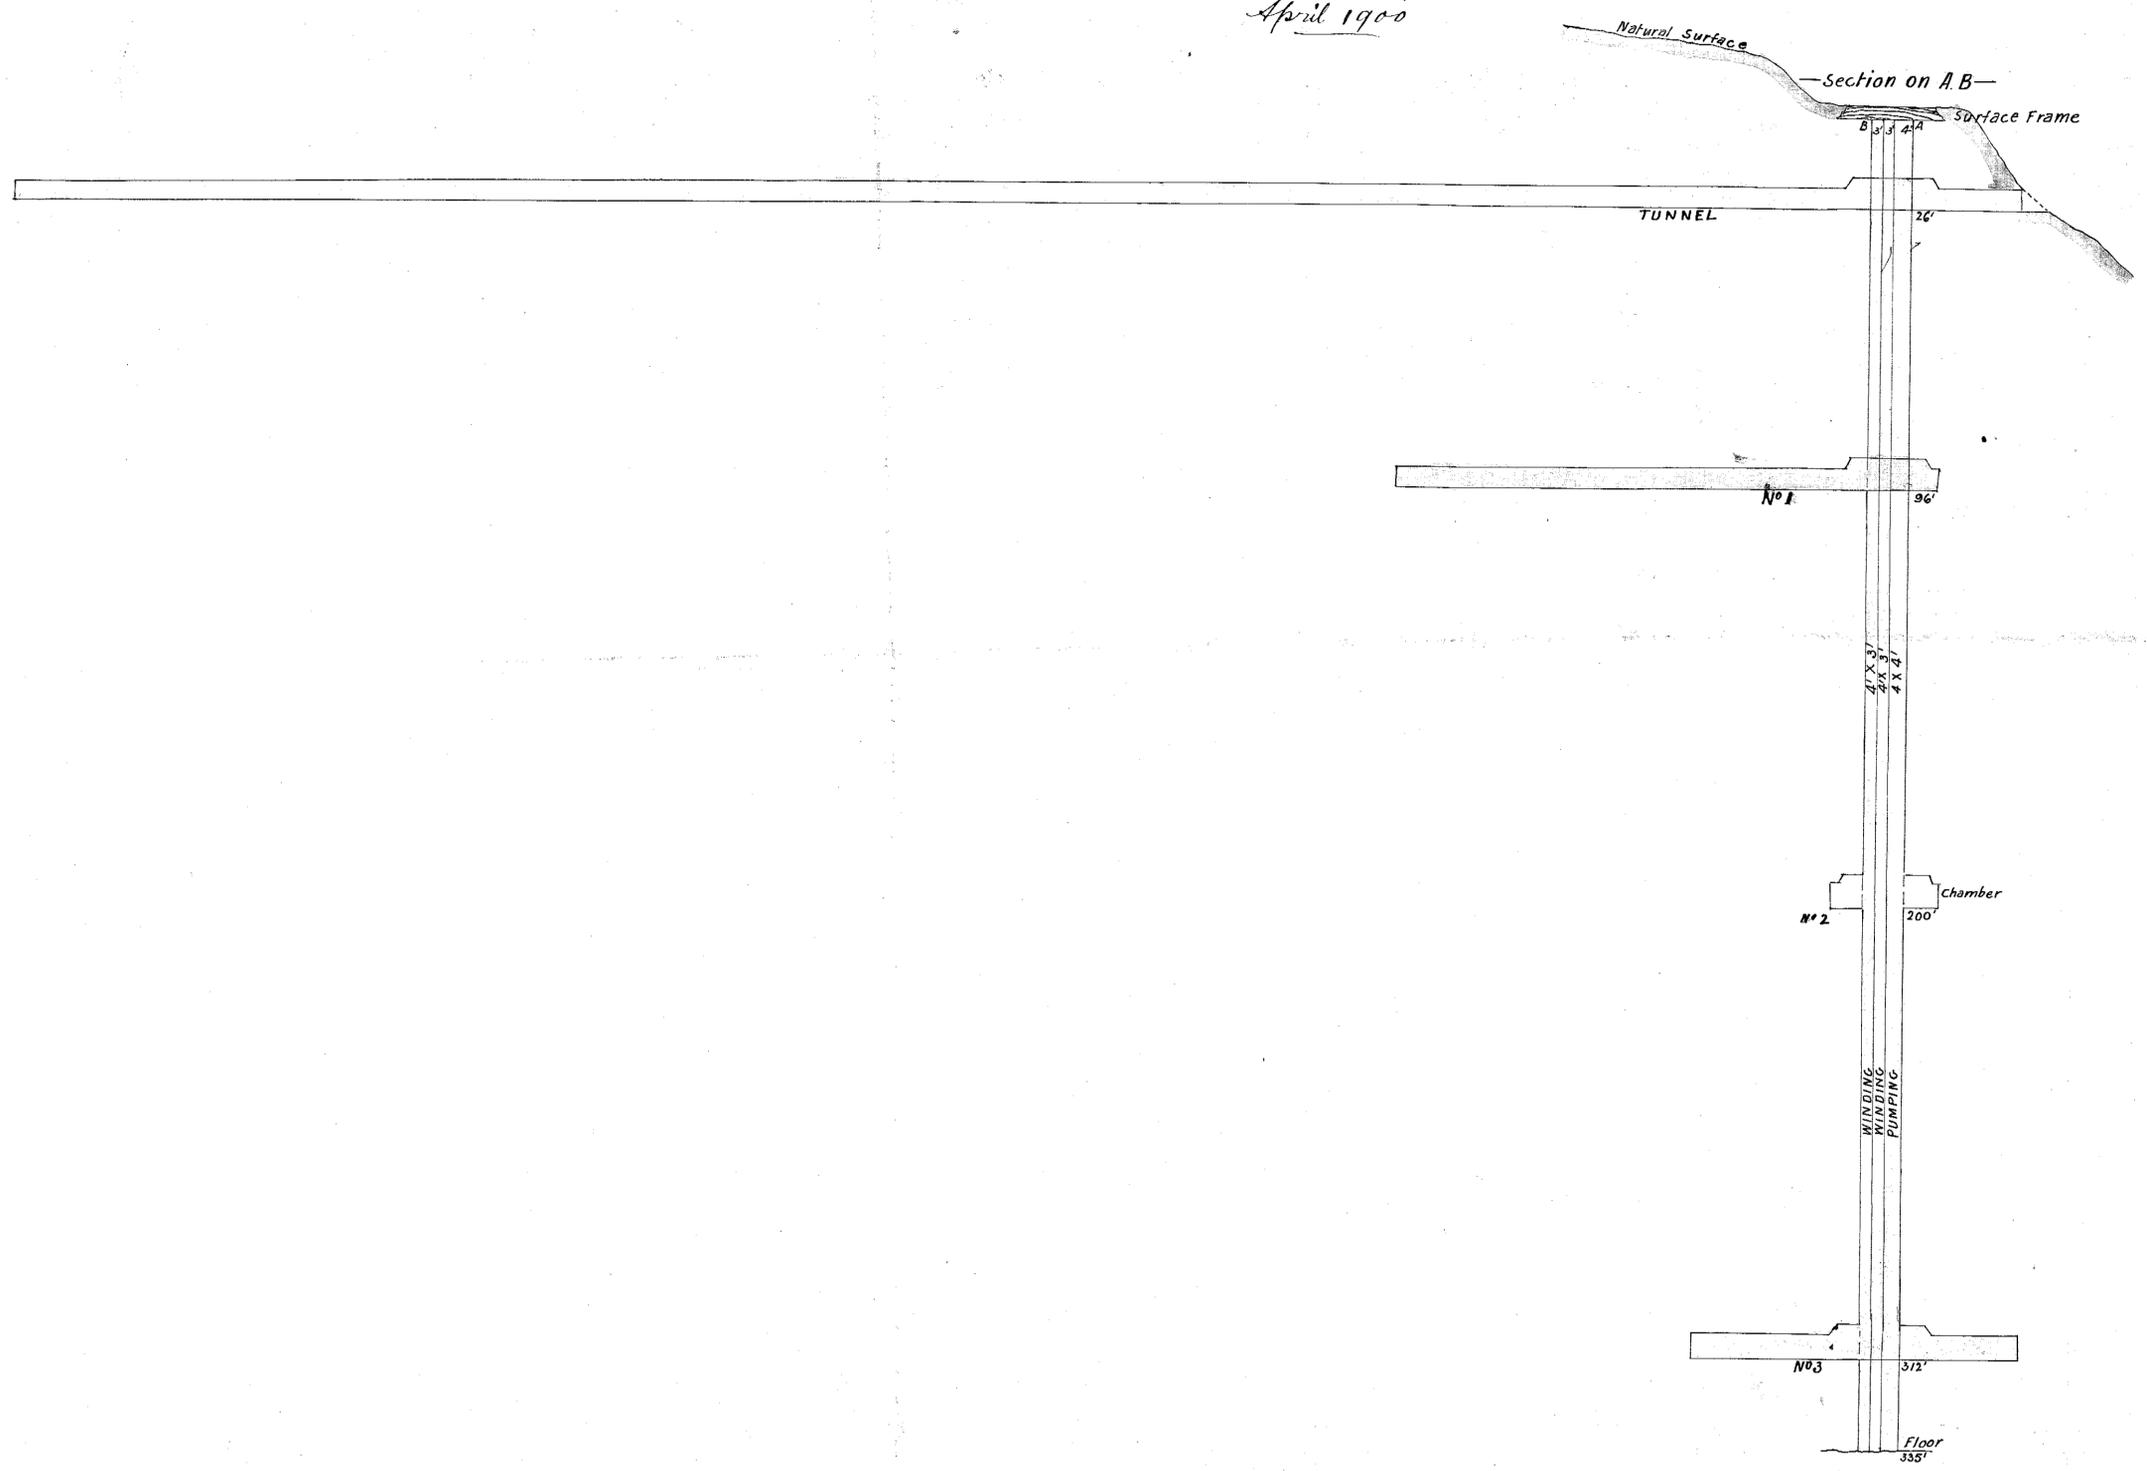

Crown Lyell Mining Co.
Printed 1889