



103-06



Stop of work

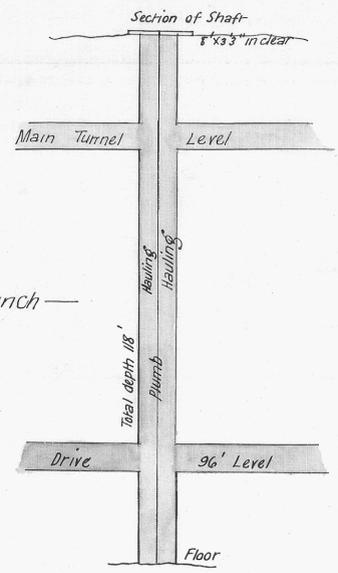

Scale 20' = 1 inch

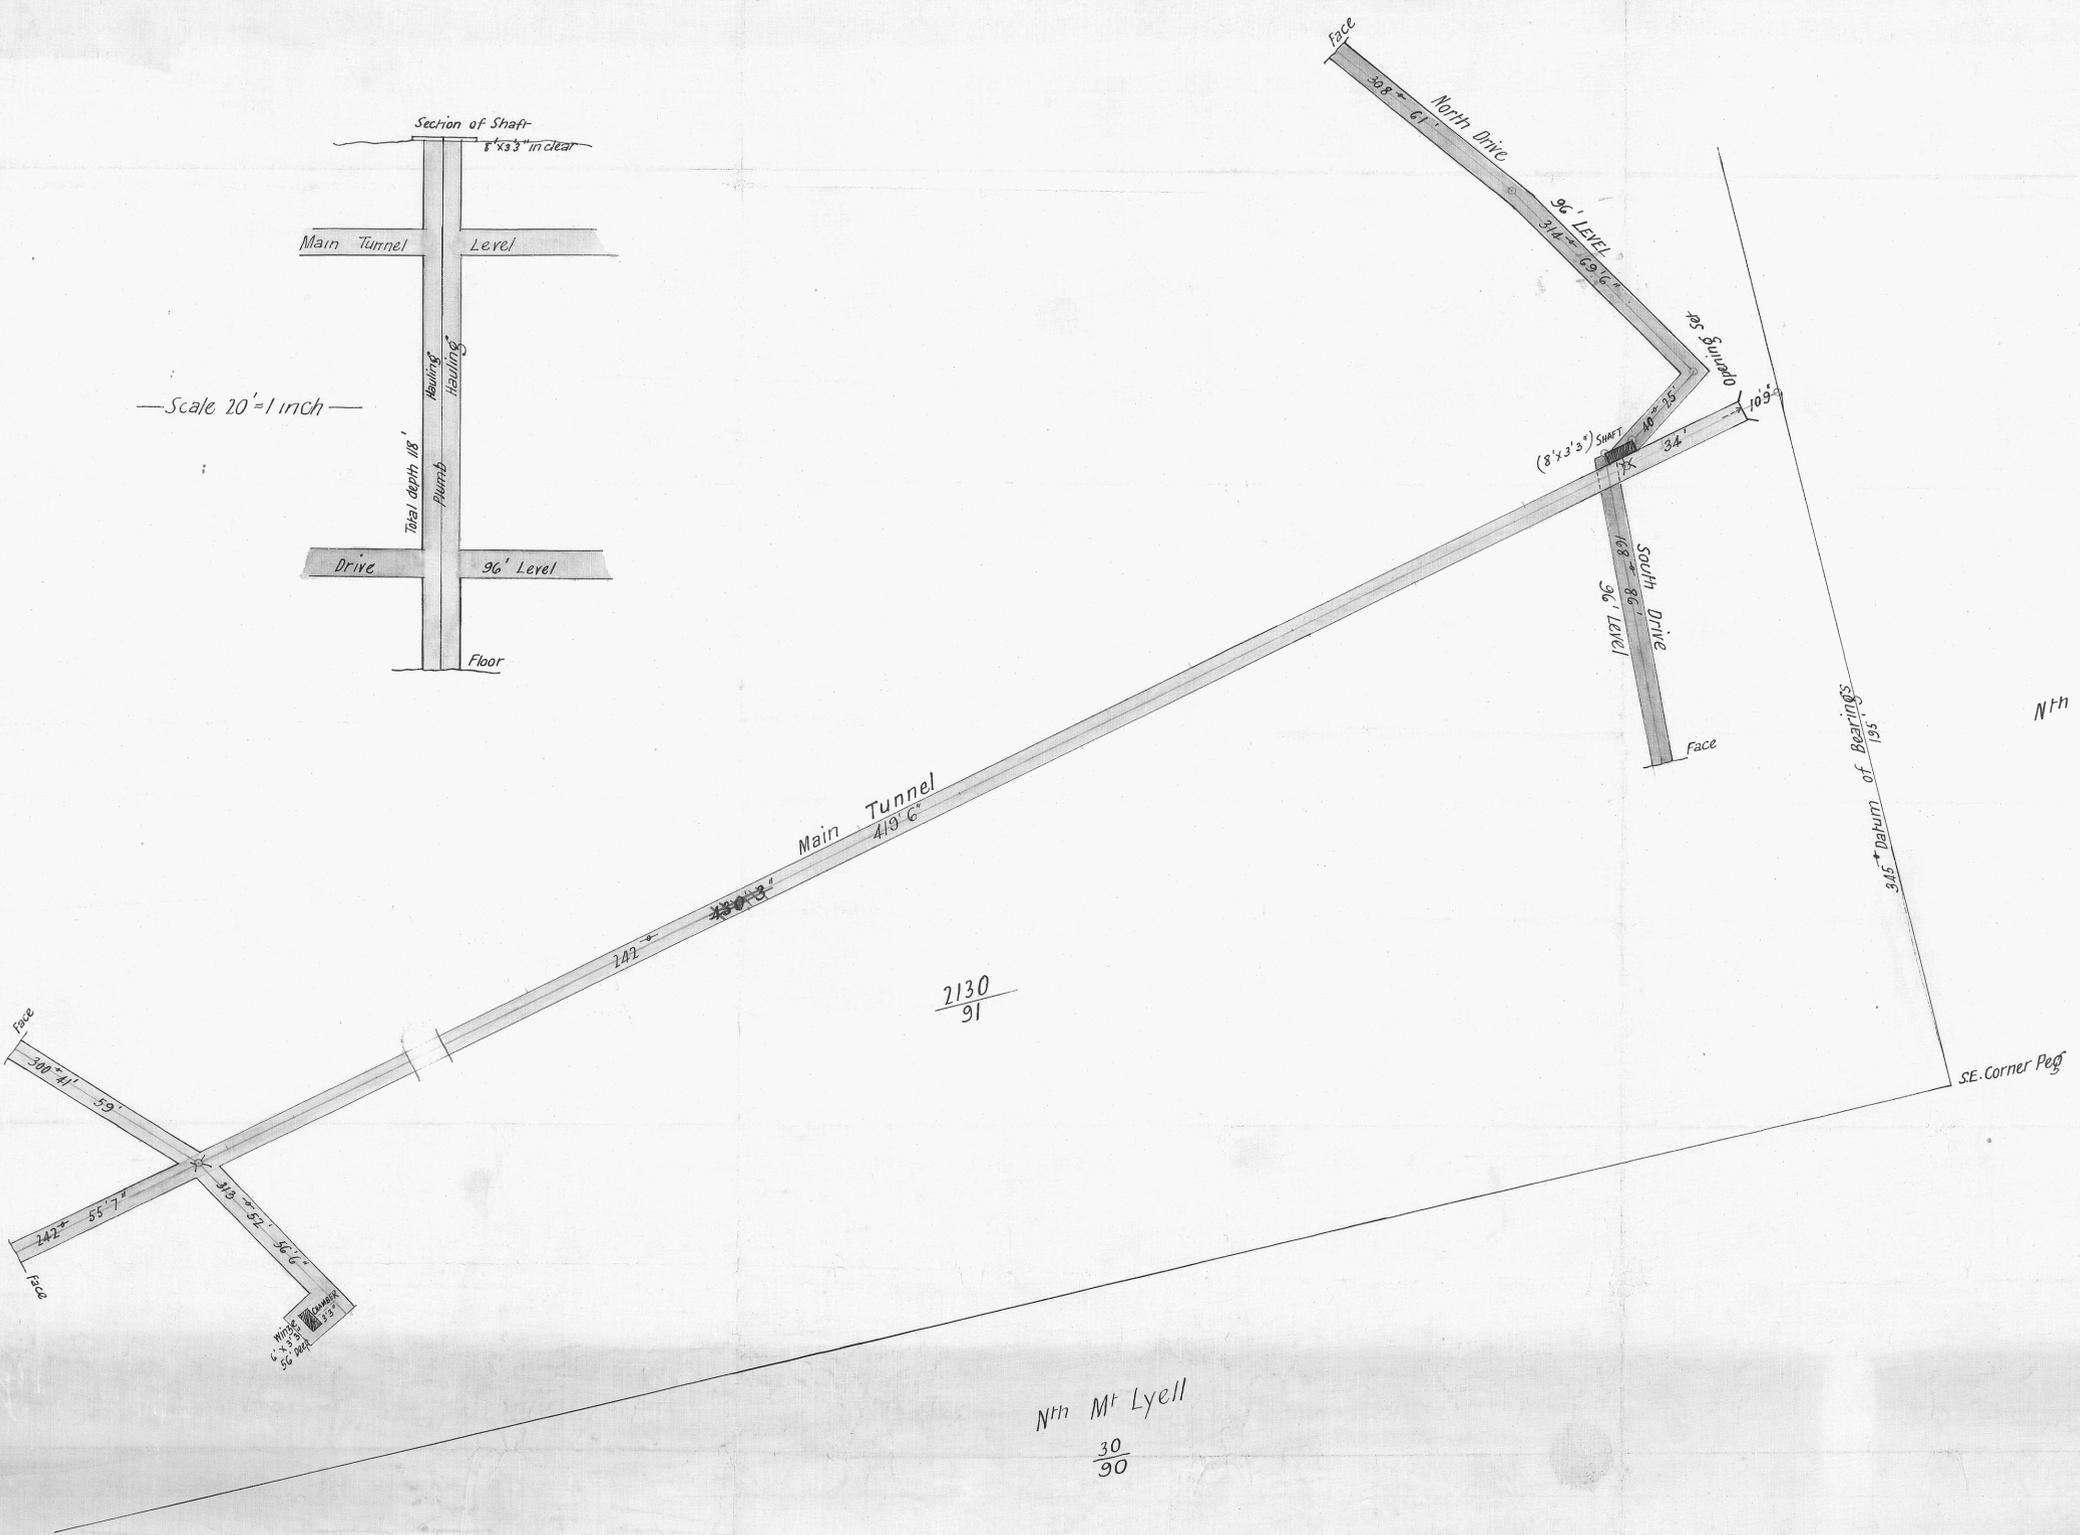

CROWN LYELL M^C CO

Underground Survey For 1898

Nth M^r Lyell CO
29/90

25 Feet to an Inch

J. J. Fellows
Authorized Surveyor
April 99
J. J. Fellows
Surveyor General
California



Nth M^r Lyell
30/90

Stop of work