


1001  
1002  
1003  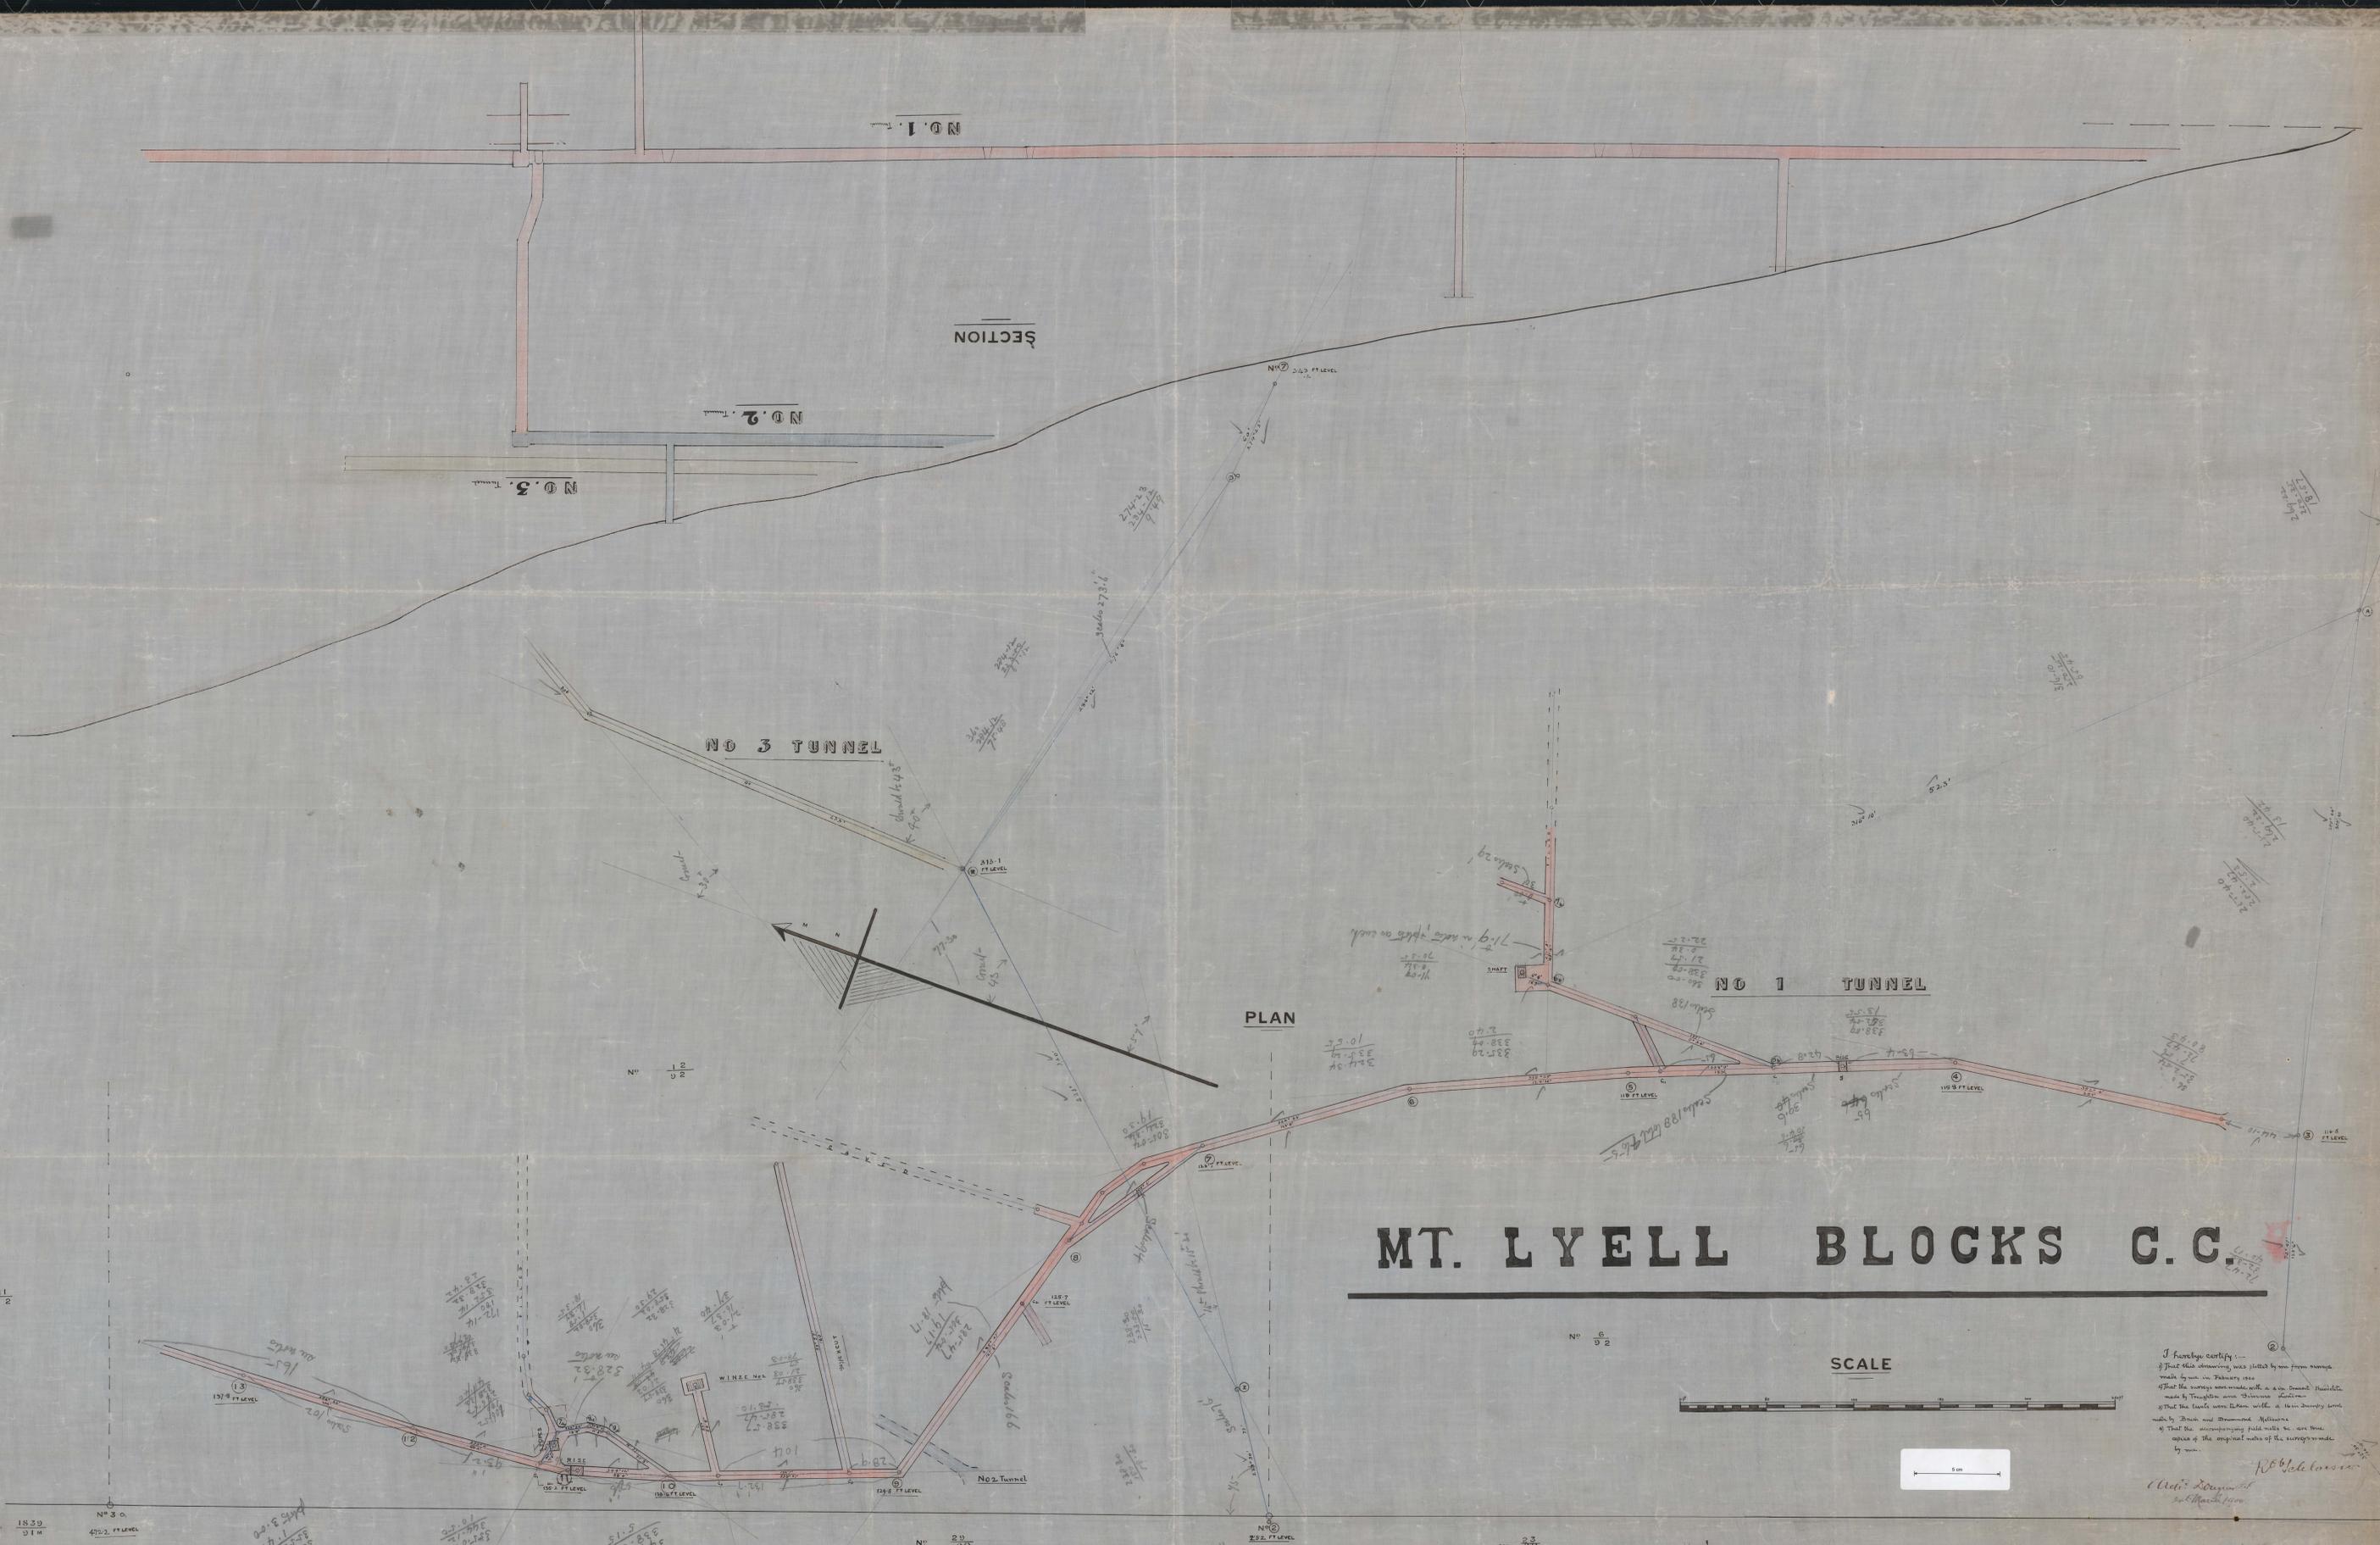
# MT. LYELL BLOCKS C.C.

SCALE



I hereby certify:  
 1) That the accompanying map is a true and correct copy of the original maps made by me on February 1880  
 2) That the surveys were made with a 6 in. Transit, theodolite made by Fraughton and Co. Boston, Massachusetts  
 3) That the levels were taken with a four foot level made by Smith and Brimmer, Baltimore  
 4) That the accompanying field notes are true copies of the original notes of the surveys made by me.

*R. B. Johnson*  
 Civil Engineer  
 1001  
 1002  
 1003  
 1020