


MOUNT LYELL BLOCKS

MINING COY No LIA:

UNDERGROUND WORKINGS

SCALE OF FEET

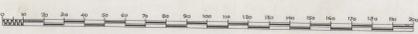

NORTH
MOUNT

29-90
10 Ac


12-92
10 Ac

23-90
10 Ac

6-92
10 Ac

LYELL M. CO. N. L.

MINING EASEMENT
NORTH MOUNT LYELL
M. CO. No Lia.

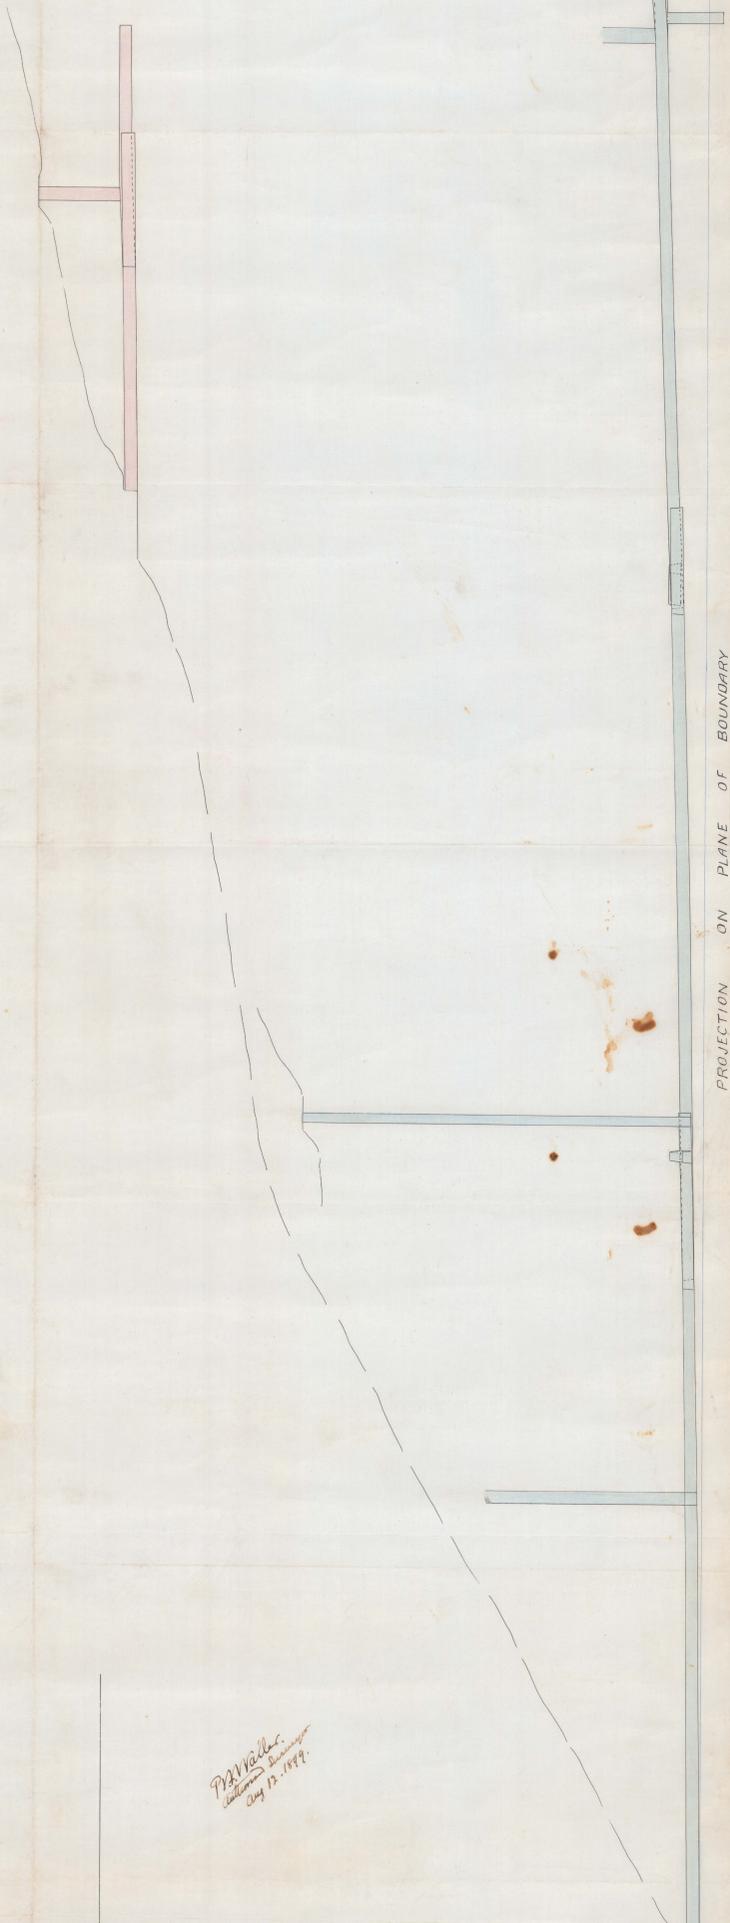

PROJECTION ON PLANE OF BOUNDARY

*P. Walker
Surveyor
Aug 13, 1899.*



*Aug 13, 1899
P. Walker*