




M<sup>T</sup> LYELL BLOCKS COPPER MINES NO LIA.  
PLAN

SCALE 1" = 40 FEET

| REFERENCE       |        |
|-----------------|--------|
| 1000 FEET LEVEL | Red    |
| 1100            | Yellow |
| 1200            | Green  |
| 1300            | Blue   |

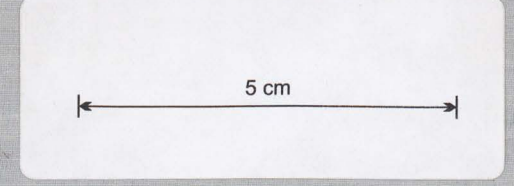

J. H. Curran  
30/5/16