

5 cm


105-07_B

M^T LYELL BLOCKS M. CO. N.L.

PLAN OF NO. 1 LEVEL STOPE

SCALE 1 IN. = 40 FT.

Jno McRae
15/2/07

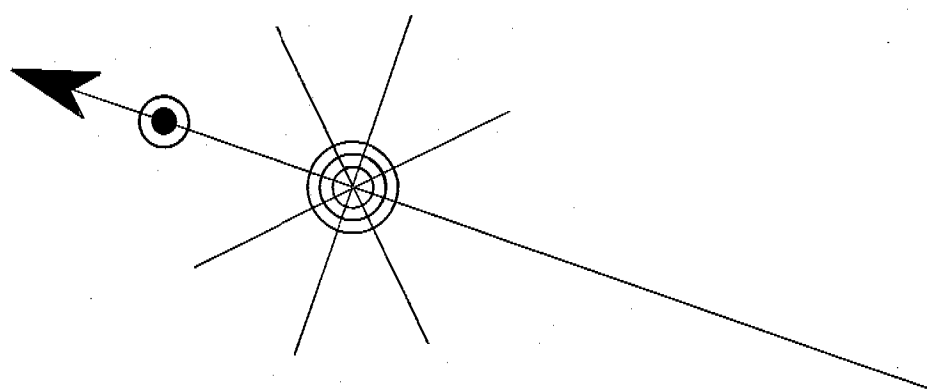

Note—Office Tunnel Sloping settled down to back of this floor on Nos. 1 & 3 & 5 Stopes.

No. 11 FLOOR

Note—Office Tunnel Sloping settled down to back of this floor on Nos. 6 & 8 Stopes.

No. 10 FLOOR

Note—No. 4 Stope collapsed. Office Tunnel Sloping settled to back of this floor.

No. 9 FLOOR

No. 8 FLOOR

FLOORS 7'6" HIGH

