

Handwritten notes in the top left corner.



105-10


MOUNT LYELL BLOCKS MINING CO. N.L.

NORTH LYELL TASMANIA.

Mine Plan.

Scale 1" = 60 feet

NORTH M. LYELL

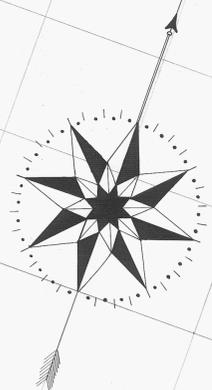

M² LYELL CONSOLS

REFERENCES

DESCRIPTION	SHOWN THUS
M ¹ TUNNEL	---
OFFICE TUNNEL	----
N ² LEVEL	
2	----
3	----
SHAFTS	⊠
VERTICAL RISES	⊞
INCLINED	⊞
STOPES	▨

Handwritten number '100'.

Small handwritten notes at the bottom right corner.