


105-11

5 cm

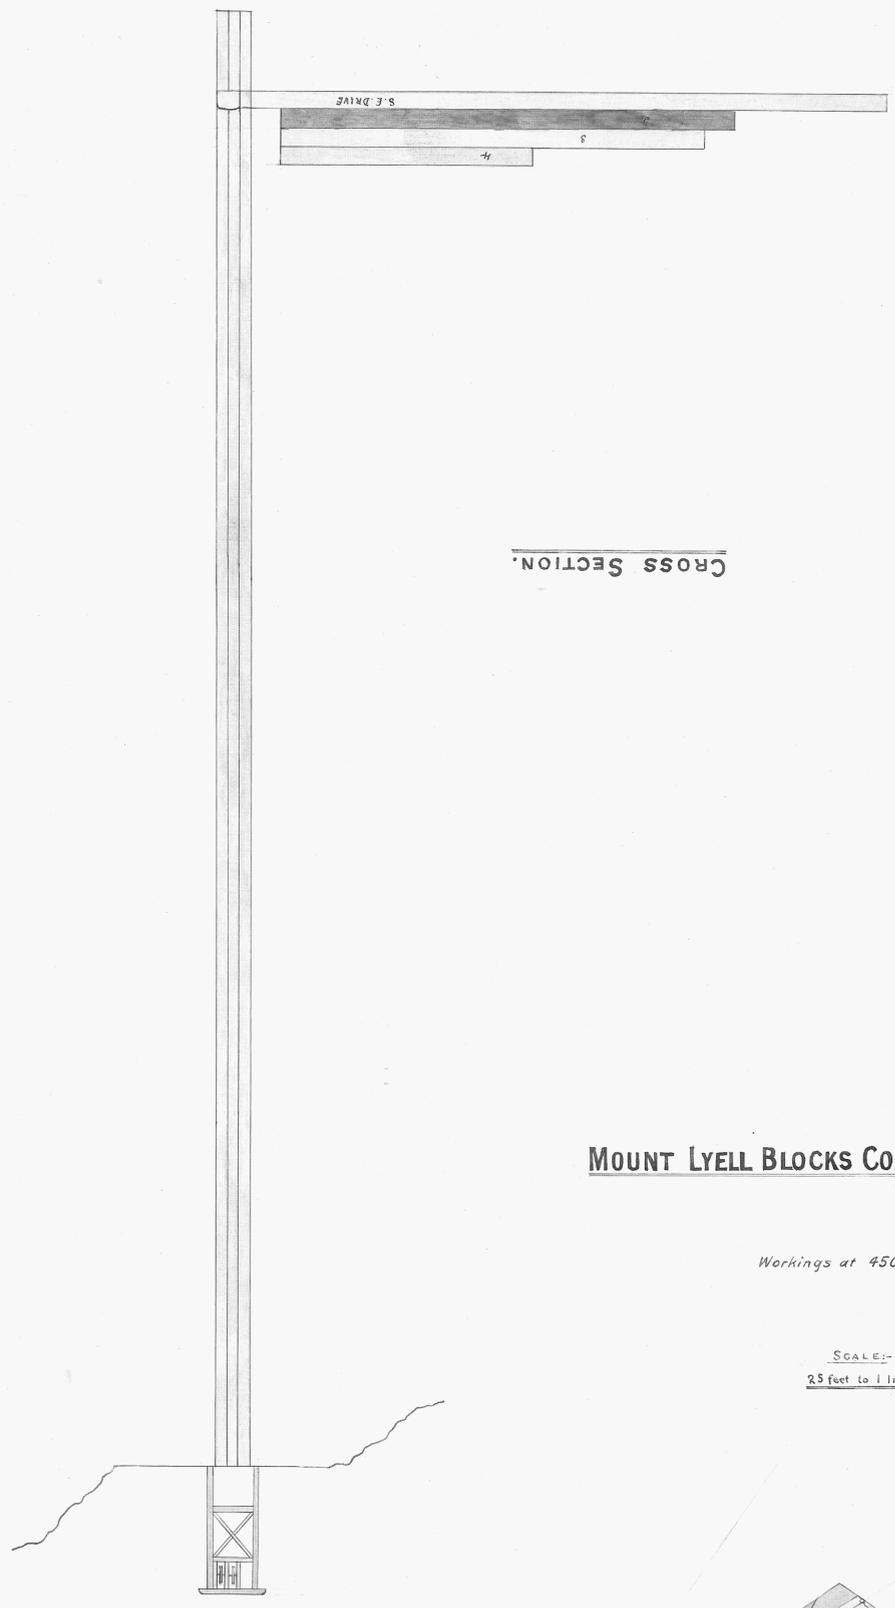


CROSS SECTION.

MOUNT LYELL BLOCKS COPPER CORP. LTD


Workings at 450' Level

SCALE:-
25 feet to 1 inch.

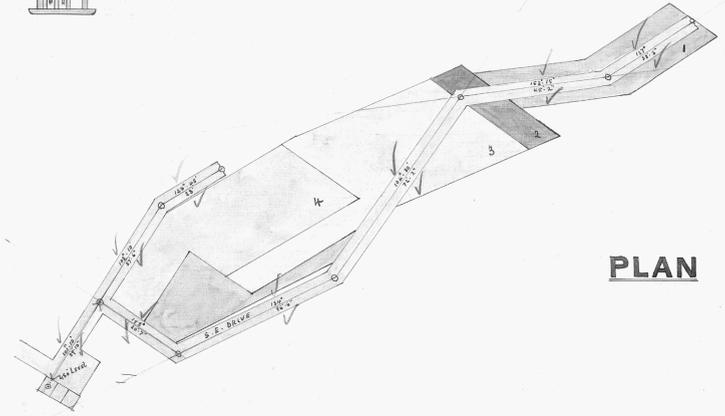

PLAN

Nº 12/92

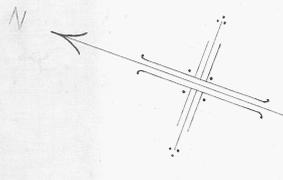

Handwritten notes on the left margin: 'add, what amount, 300, 1003'

J. H. Britton
28.2.03

6 MAR 1903

Nº 6/92