


Other floor
with glass blocks


M^T LYELL BLOCKS M. CO. N.L.

PLAN OF OFFICE TUNNEL STOPES


Scale 40ft to 1 in

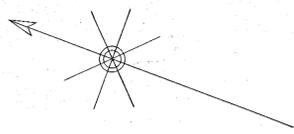


No. 8 FLOOR

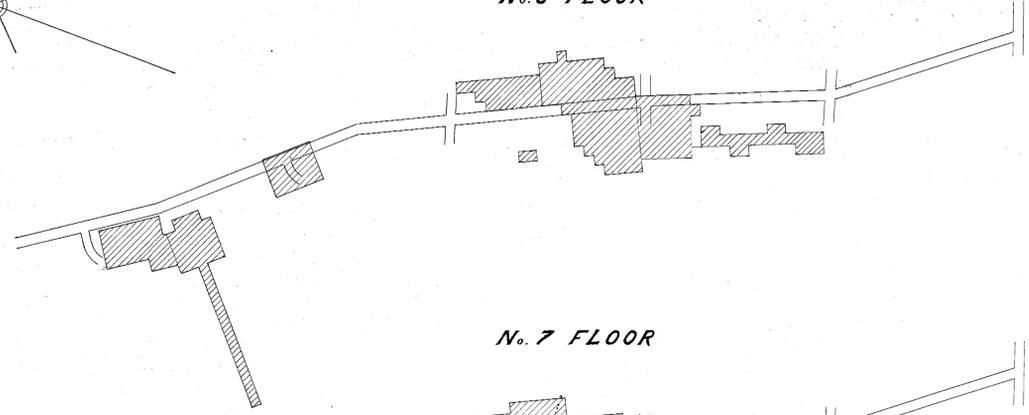


No. 7 FLOOR

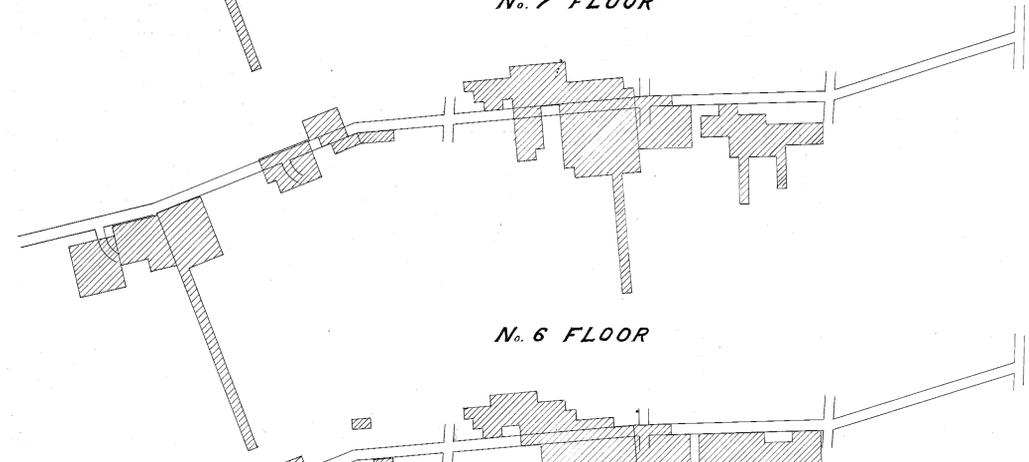


No. 6 FLOOR

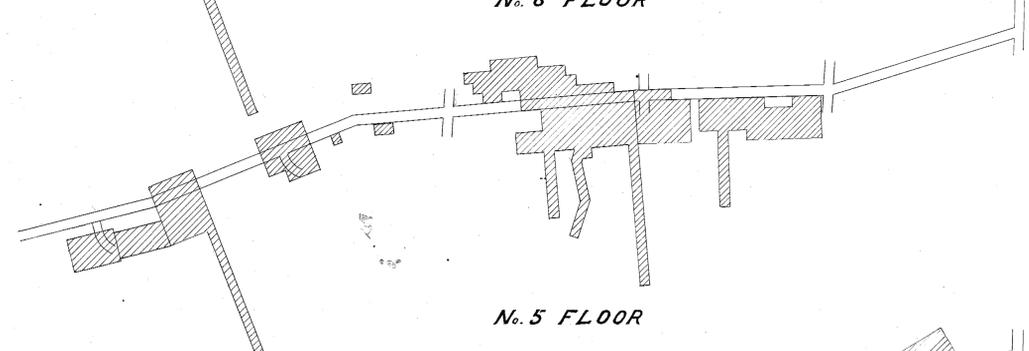


No. 5 FLOOR

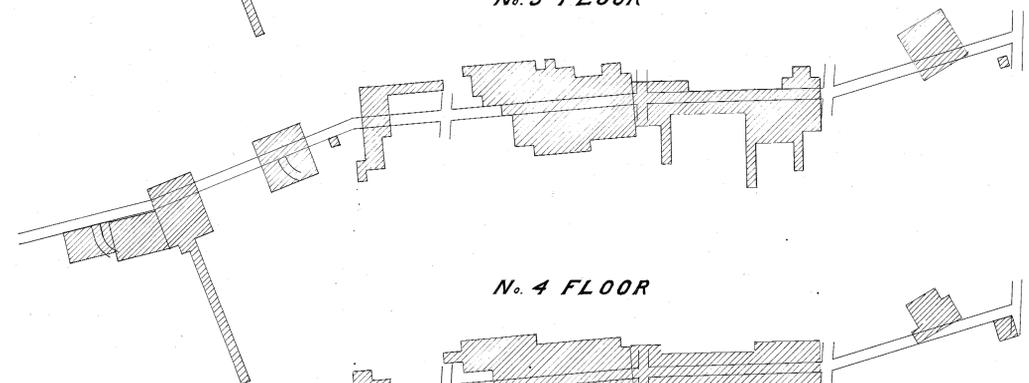


No. 4 FLOOR

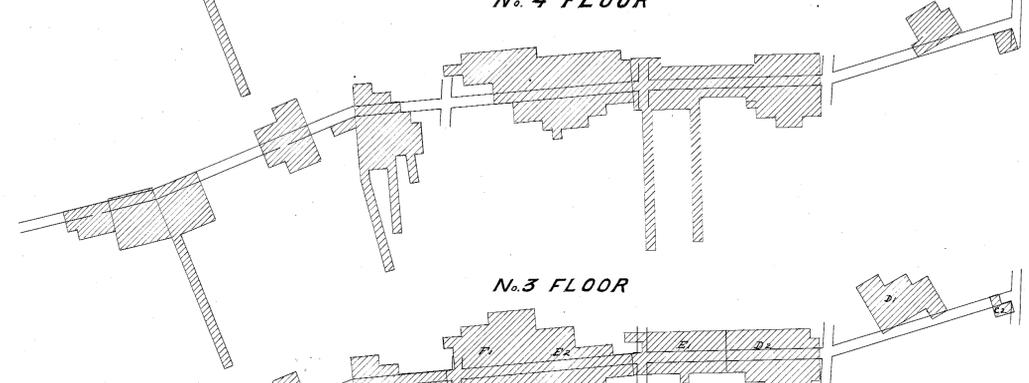

No. 3 FLOOR

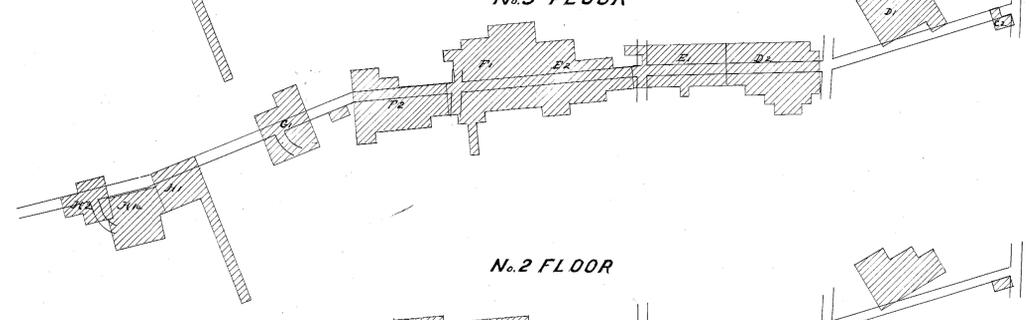

No. 2 FLOOR

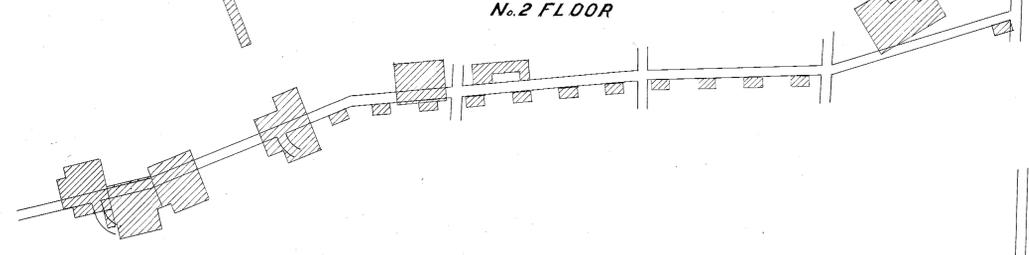

No. 1 FLOOR

