

105-13

5 cm

105-13

Handwritten notes: Mr. J. M. Peake, 18/2/07



M^T LYELL BLOCKS M. CO. N.L.

PLAN OF OFFICE TUNNEL STOPES


Showing stoping for year ending 31st Dec 1907.

SCALE — 1 INCH — 40 FEET


*Jno. M^cPeake
18/2/07*

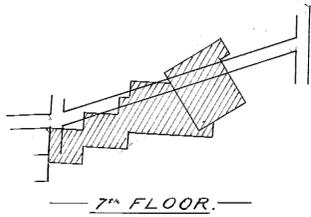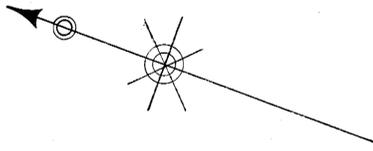


7th FLOOR.

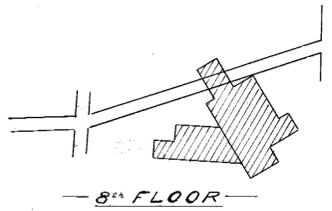


8th FLOOR

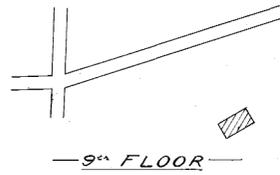


9th FLOOR

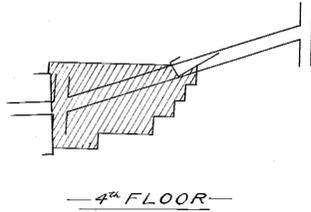


4th FLOOR

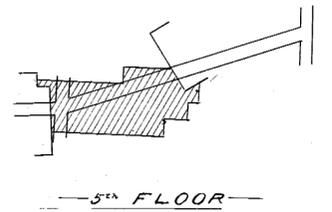


5th FLOOR

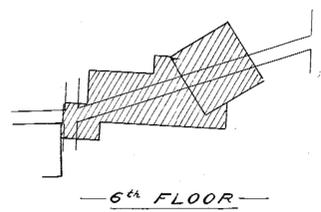


6th FLOOR

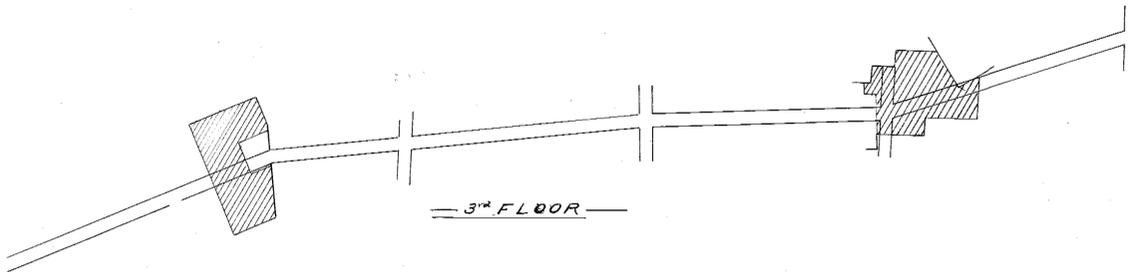

3rd FLOOR

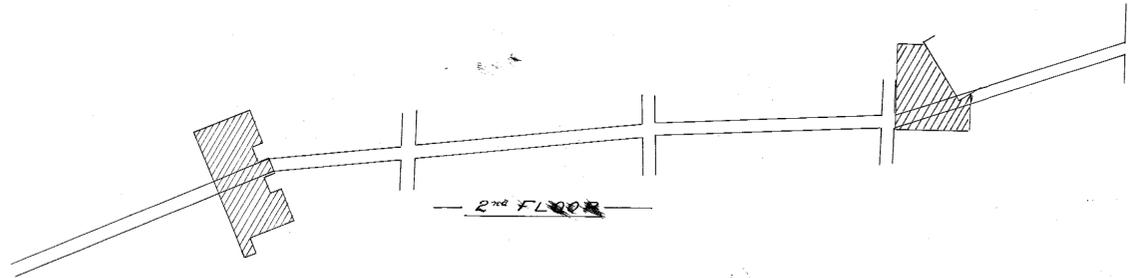

2nd FLOOR

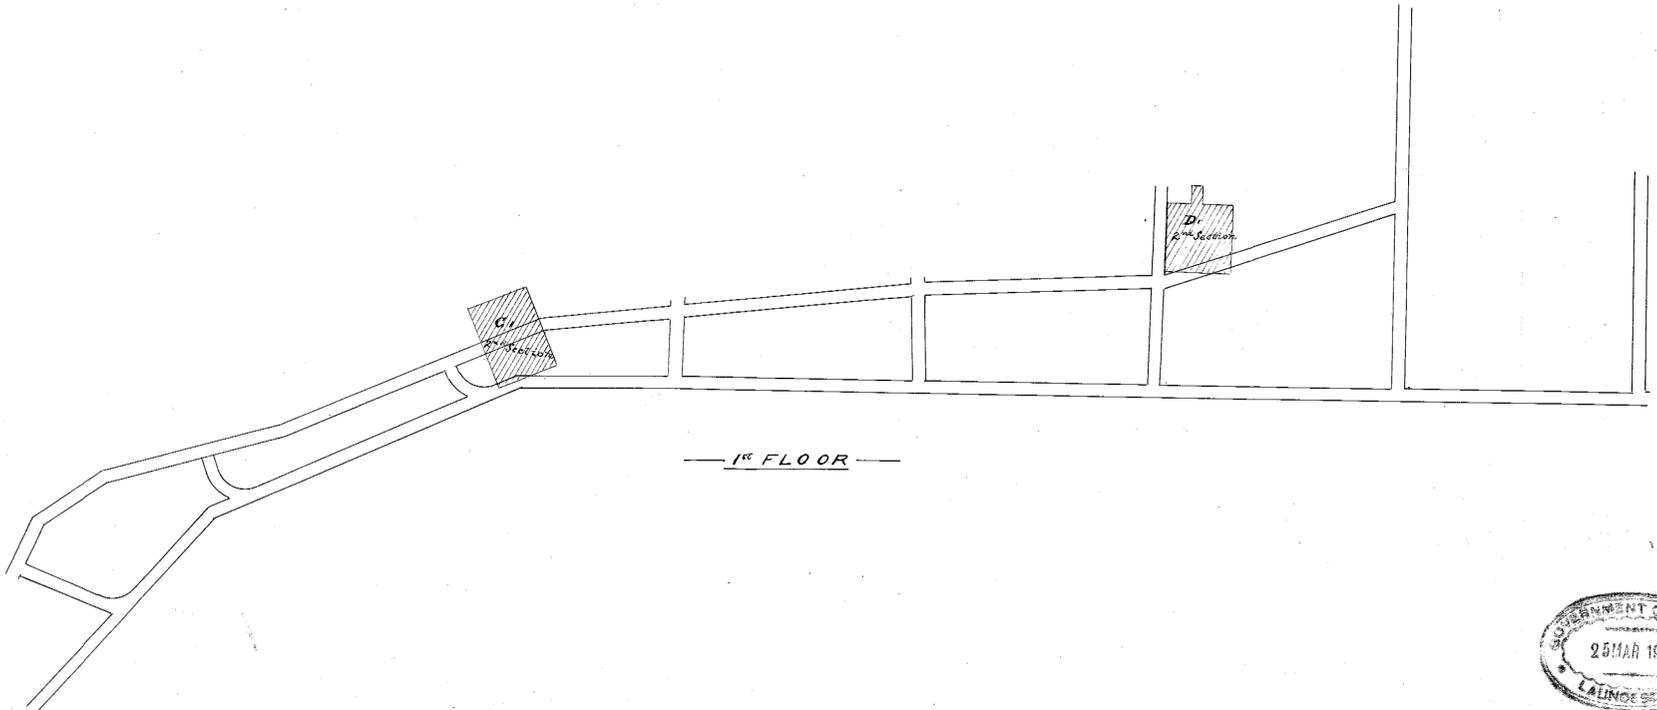

1st FLOOR

