

5 cm

M^T LYELL BLOCKS M. CO. N.L.



PLAN

— SHEWING ALL DRIVING, RISING, AND SINKING, —

— FOR YEAR ENDING 31st DECEMBER 1907. —

— Scale—Forty feet to an inch. —

Geo M Peake
2/2/07

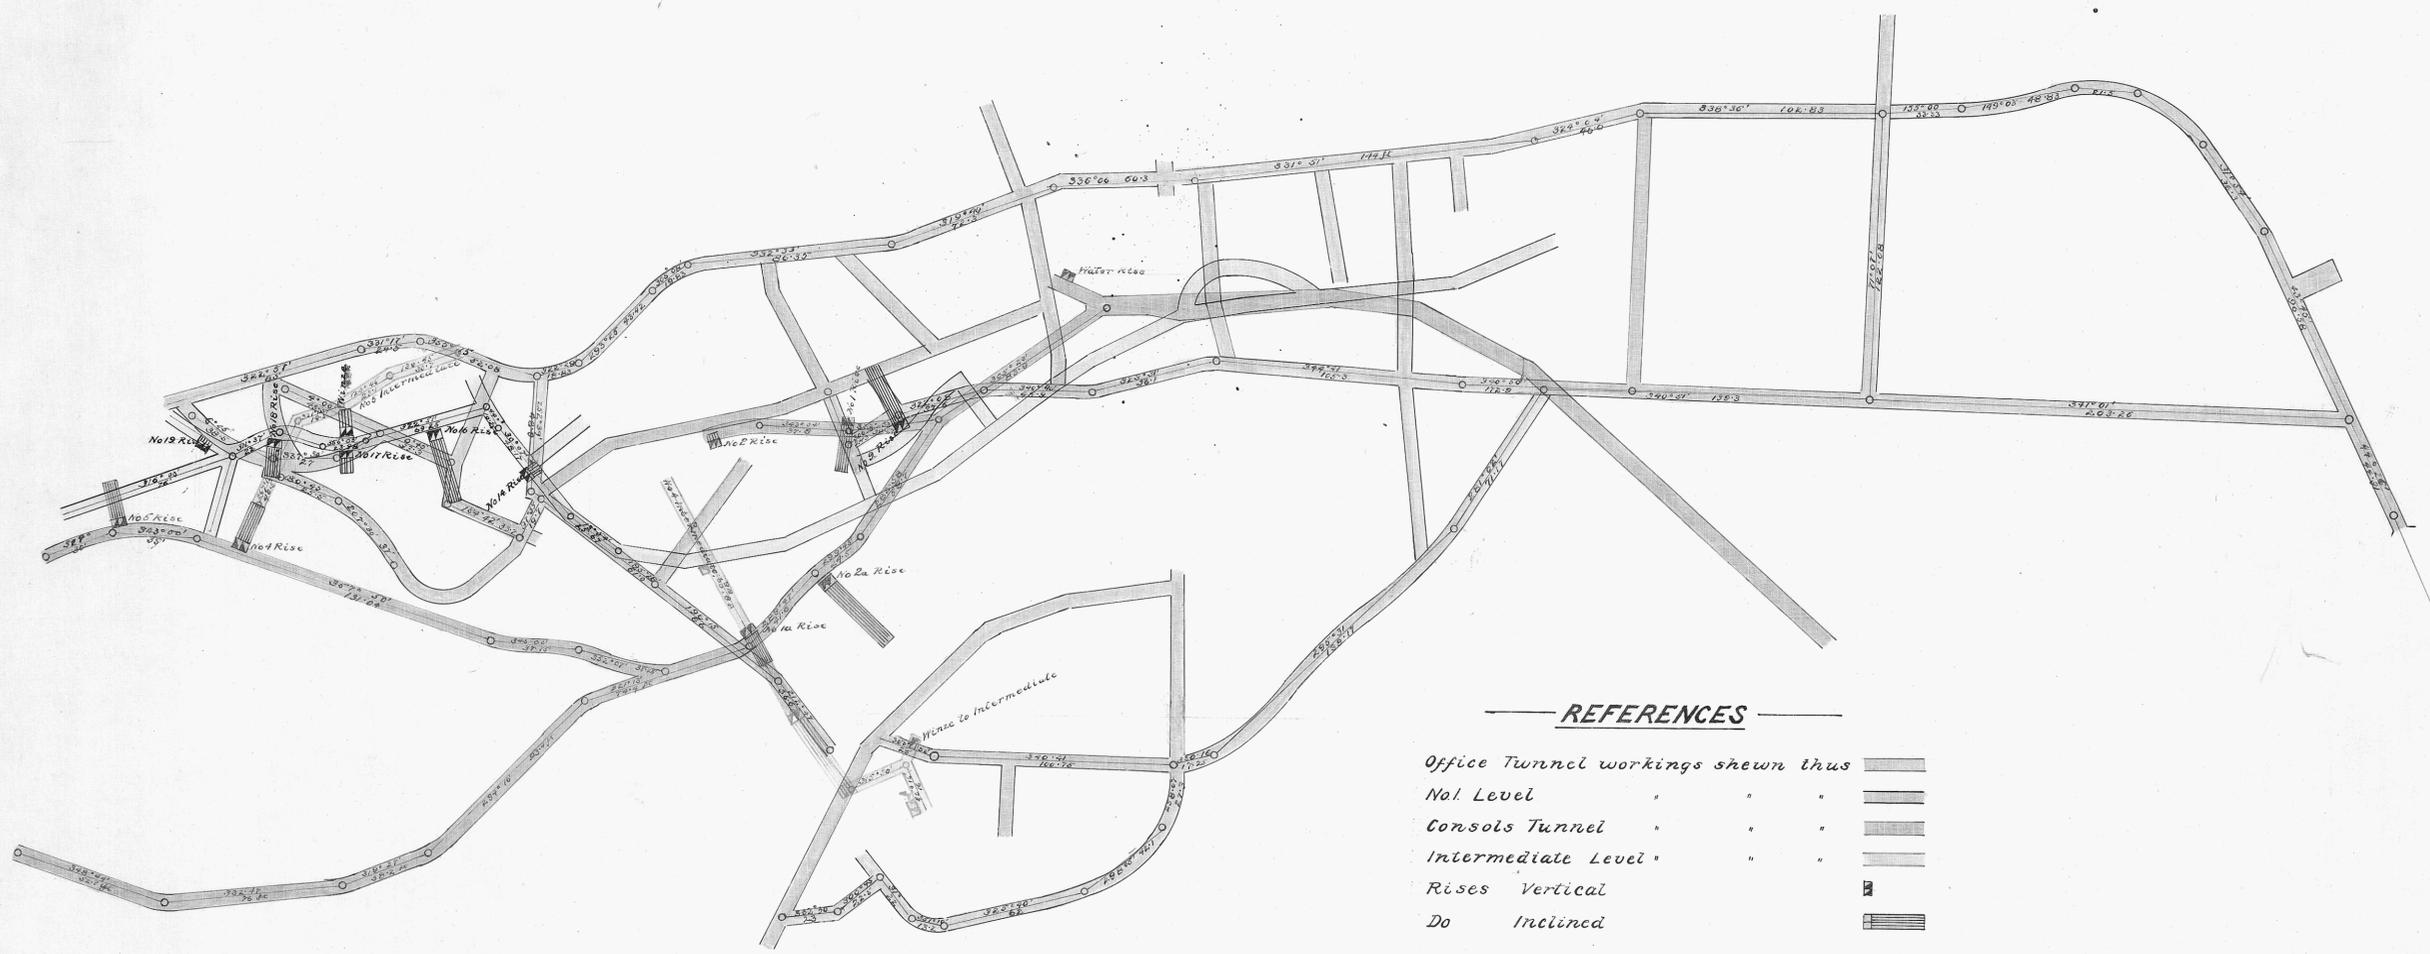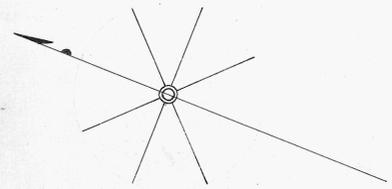

REFERENCES

- Office Tunnel workings shewn thus 
- No. 1 Level " " " 
- Consols Tunnel " " " 
- Intermediate Level " " " 
- Rises Vertical 
- Do Inclined 

