

5 cm



105-15

# MOUNT LYELL BLOCKS MINING CO., N.L.


## PLAN OF BALANCE SHAFT STOPES, No. 1 LEVEL.

SCALE. 1 inch = 40 feet.


*Jno M. Peake*  
10/2/07

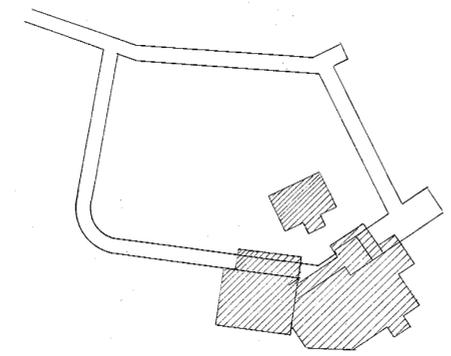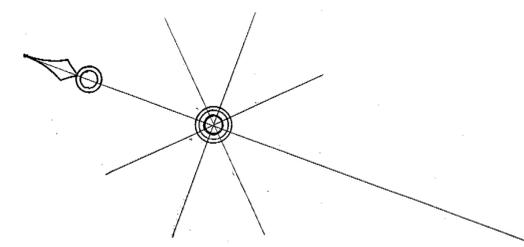


No. 9 FLOOR

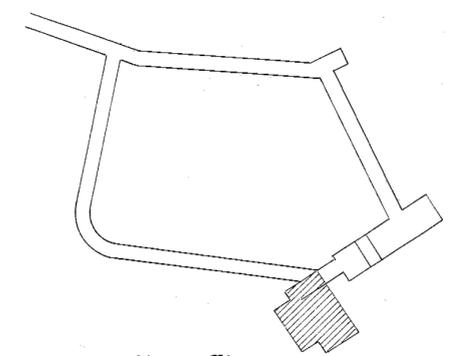


No. 10 FLOOR

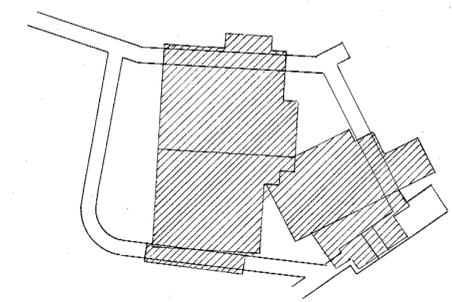


No. 5 FLOOR

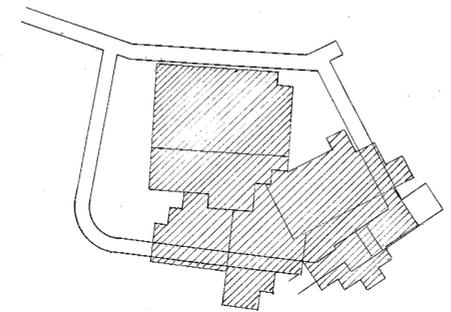


No. 6 FLOOR

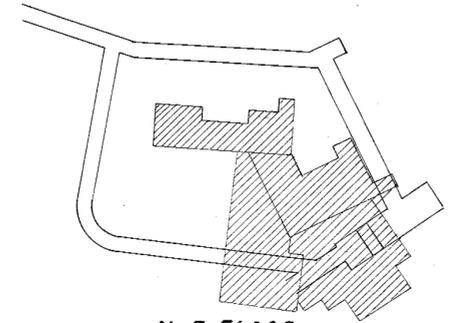


No. 7 FLOOR

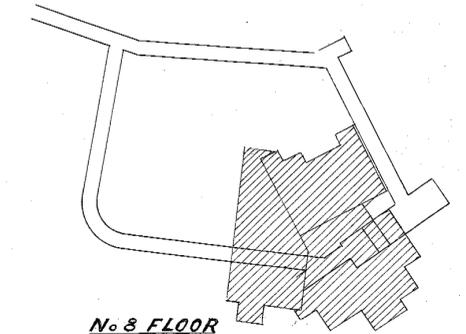


No. 8 FLOOR

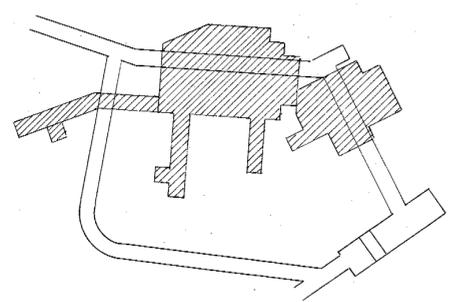


No. 1 FLOOR

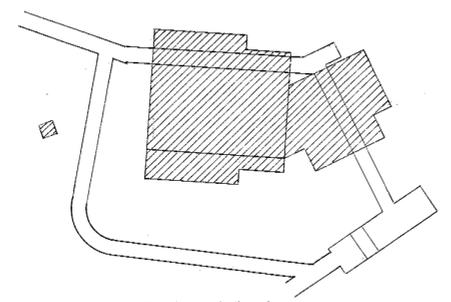

No. 2 FLOOR

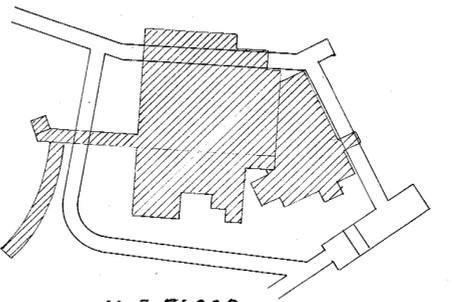

No. 3 FLOOR

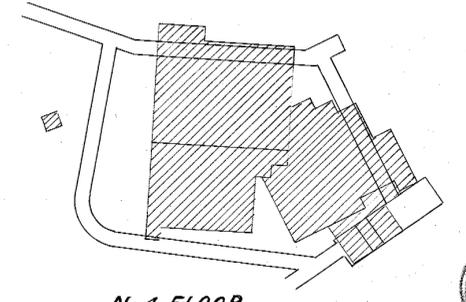

No. 4 FLOOR

Floors 7' 6" high

