


105-18

105-18

5 cm

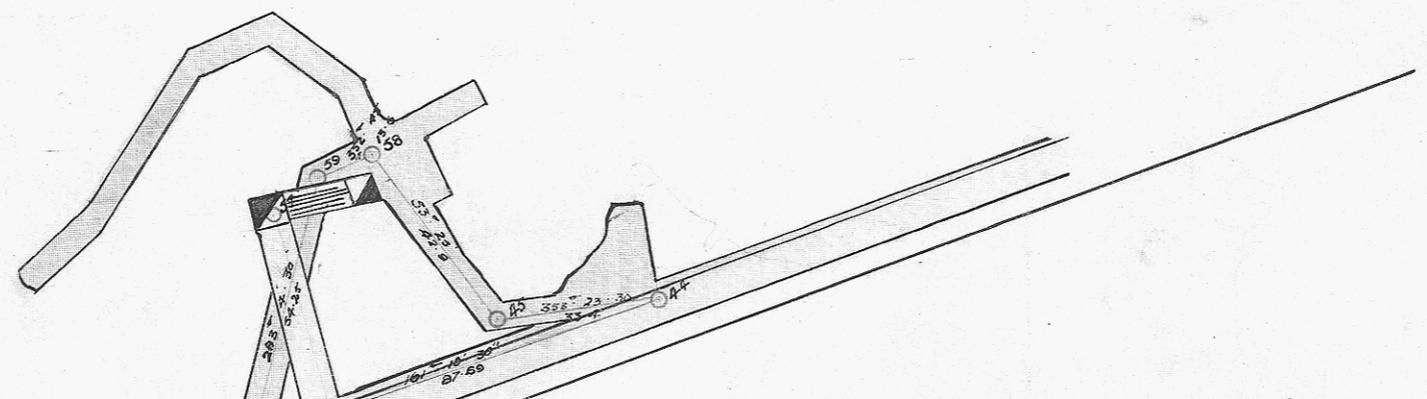

MOUNT LYELL BLOCKS COPPER MINES N.L.

PLAN OF UNDERGROUND WORKINGS

SCALE 40 FEET = 1 INCH.

REFERENCE LEVEL COLOUR

- 1100 Ft.
- 1200 "
- 1300 "

M. A. W. L.
M. T. W. 30/12/17



No 49 Slope
 Nth LYELL MINE.