
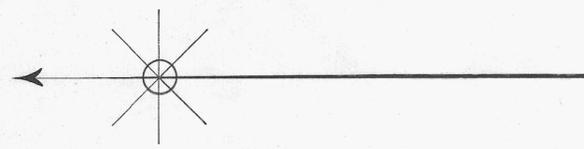


5 cm

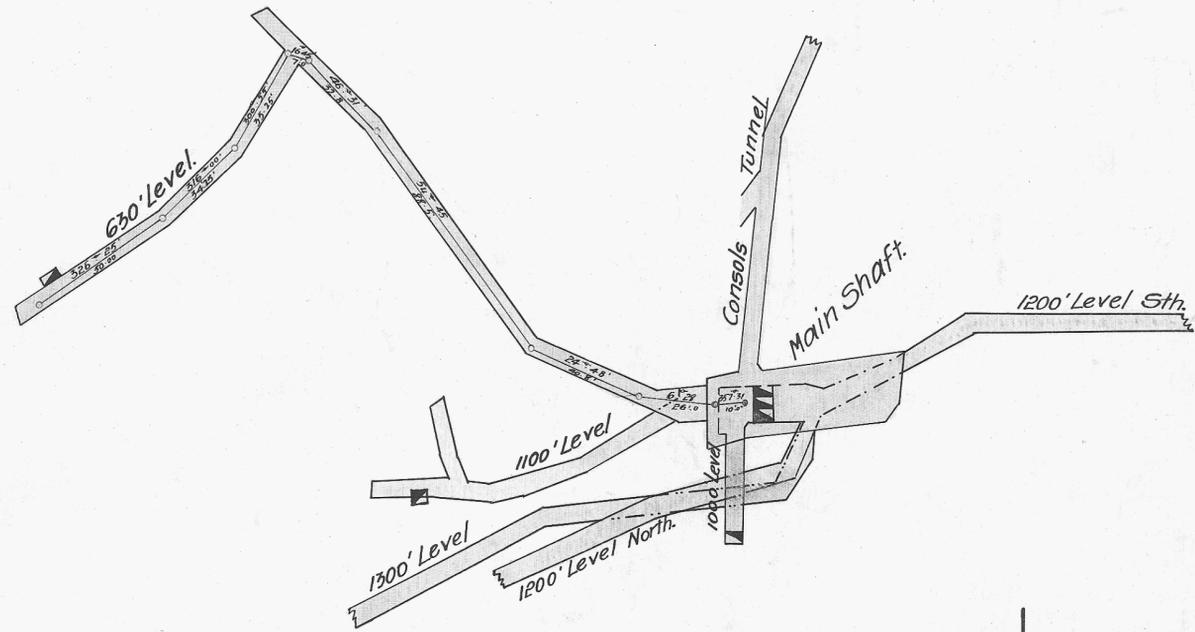

REFERENCE.	
LEVEL.	COLOR.
Consols	
630'	
1000'	
1100'	
1200'	
1300'	

THE MOUNT LYELL BLOCKS COPPER MINES N.L.

Plan of Underground Workings  
 shewing  
 Extensions to Nov<sup>r</sup> 1<sup>st</sup> 19.  
 Scale 1" = 40'.

*M. Paroll*  
 Mgr.