

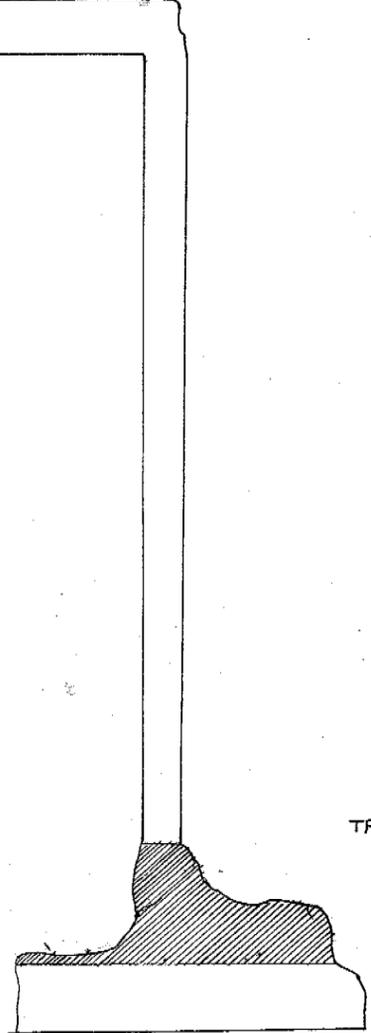


PLAN

5 cm

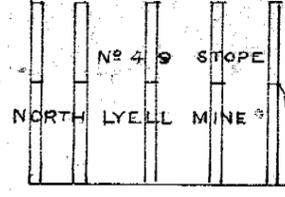

TRANVERSE SECTION

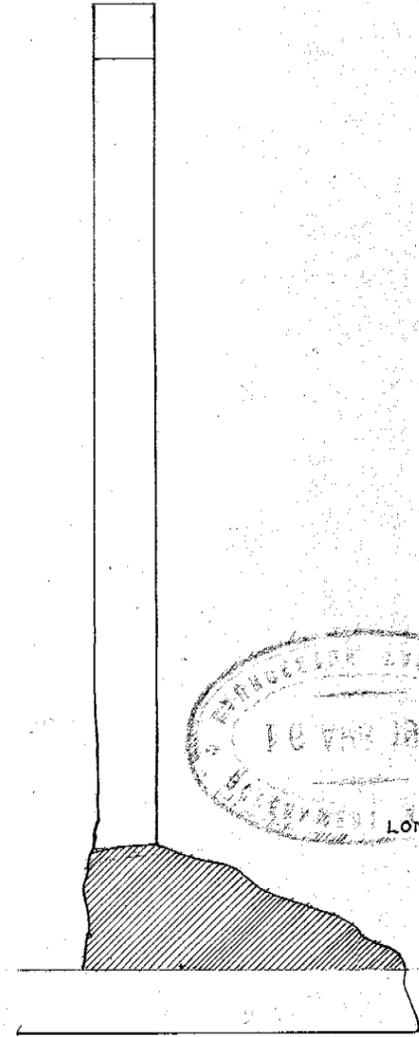

LONGITUDINAL SECTION

105-21

MOUNT LYELL BLOCKS COPPER MINE N.L.

No 2 RISE and STOPE OF 1200 FT LEVEL

SCALE 20 Feet = 1 Inch.

Marshall
in mps 31/12/17

PT 1

105-21