


# M<sup>T</sup> LYELL BLOCKS M. CO. N.L.


## PLAN OF OFFICE TUNNEL STOPES

Scale 40 ft. to 1 in.


Jno M. Peck  
24/10/05

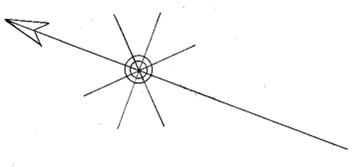


NO. 14 FLOOR

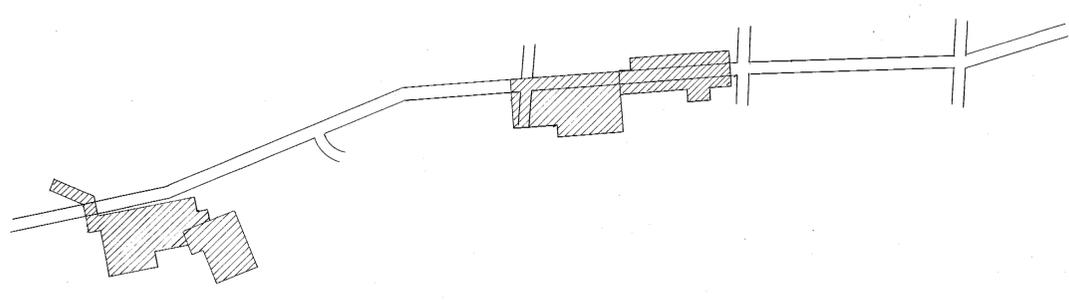


NO. 13 FLOOR

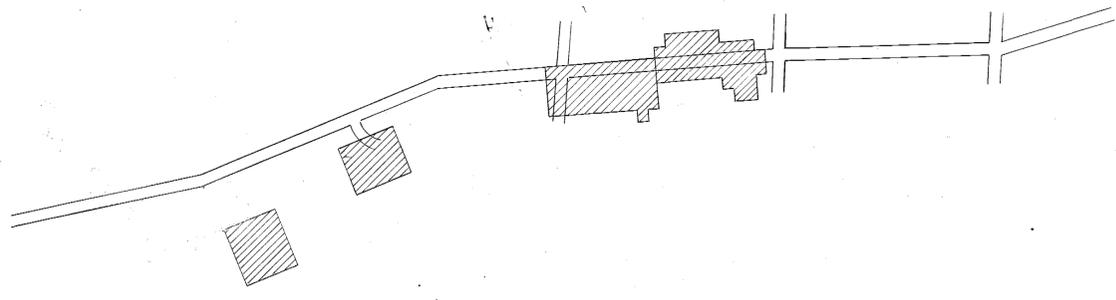


NO. 12 FLOOR

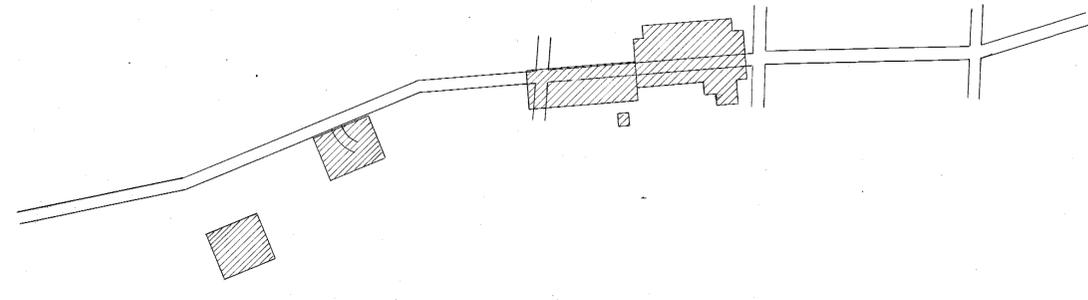

NO. 11 FLOOR

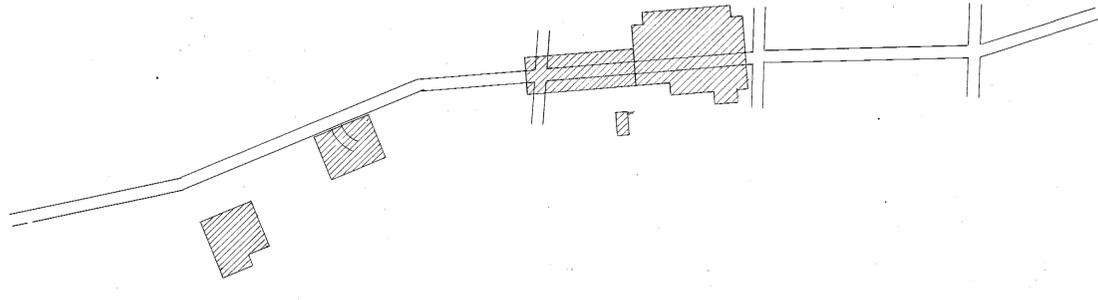

NO. 10 FLOOR

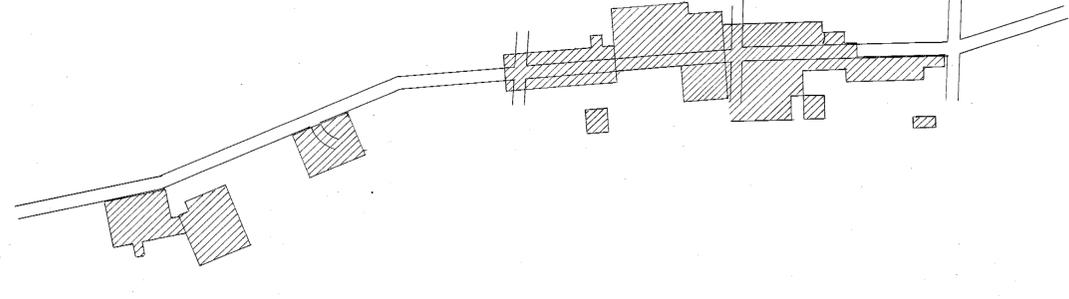

NO. 9 FLOOR

