


M^T LYELL BLOCKS M. CO. N.L.

MINE PLAN

Scale — Forty feet to an inch.

Jno. McPeck
17/3/06

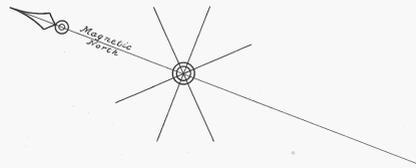

REFERENCES

Office Tunnel workings shown thus	
No. 1 Level B.S.	
No. 2 Level	
Consols Tunnel	
No. 1 Tunnel	
No. 1 Intermediate	
Other Intermediate Levels	
Rises - Vertical	
Ditto - Inclined	

9/1900

10/1900

2/96

105724



105724