



105-25

M^T LYELL BLOCKS M. CO. N.L.

PLAN OF NO. 1 LEVEL STOPES

— SCALE — 1 IN. — 40 FT. —

Geo. W. Peake
14/2/07

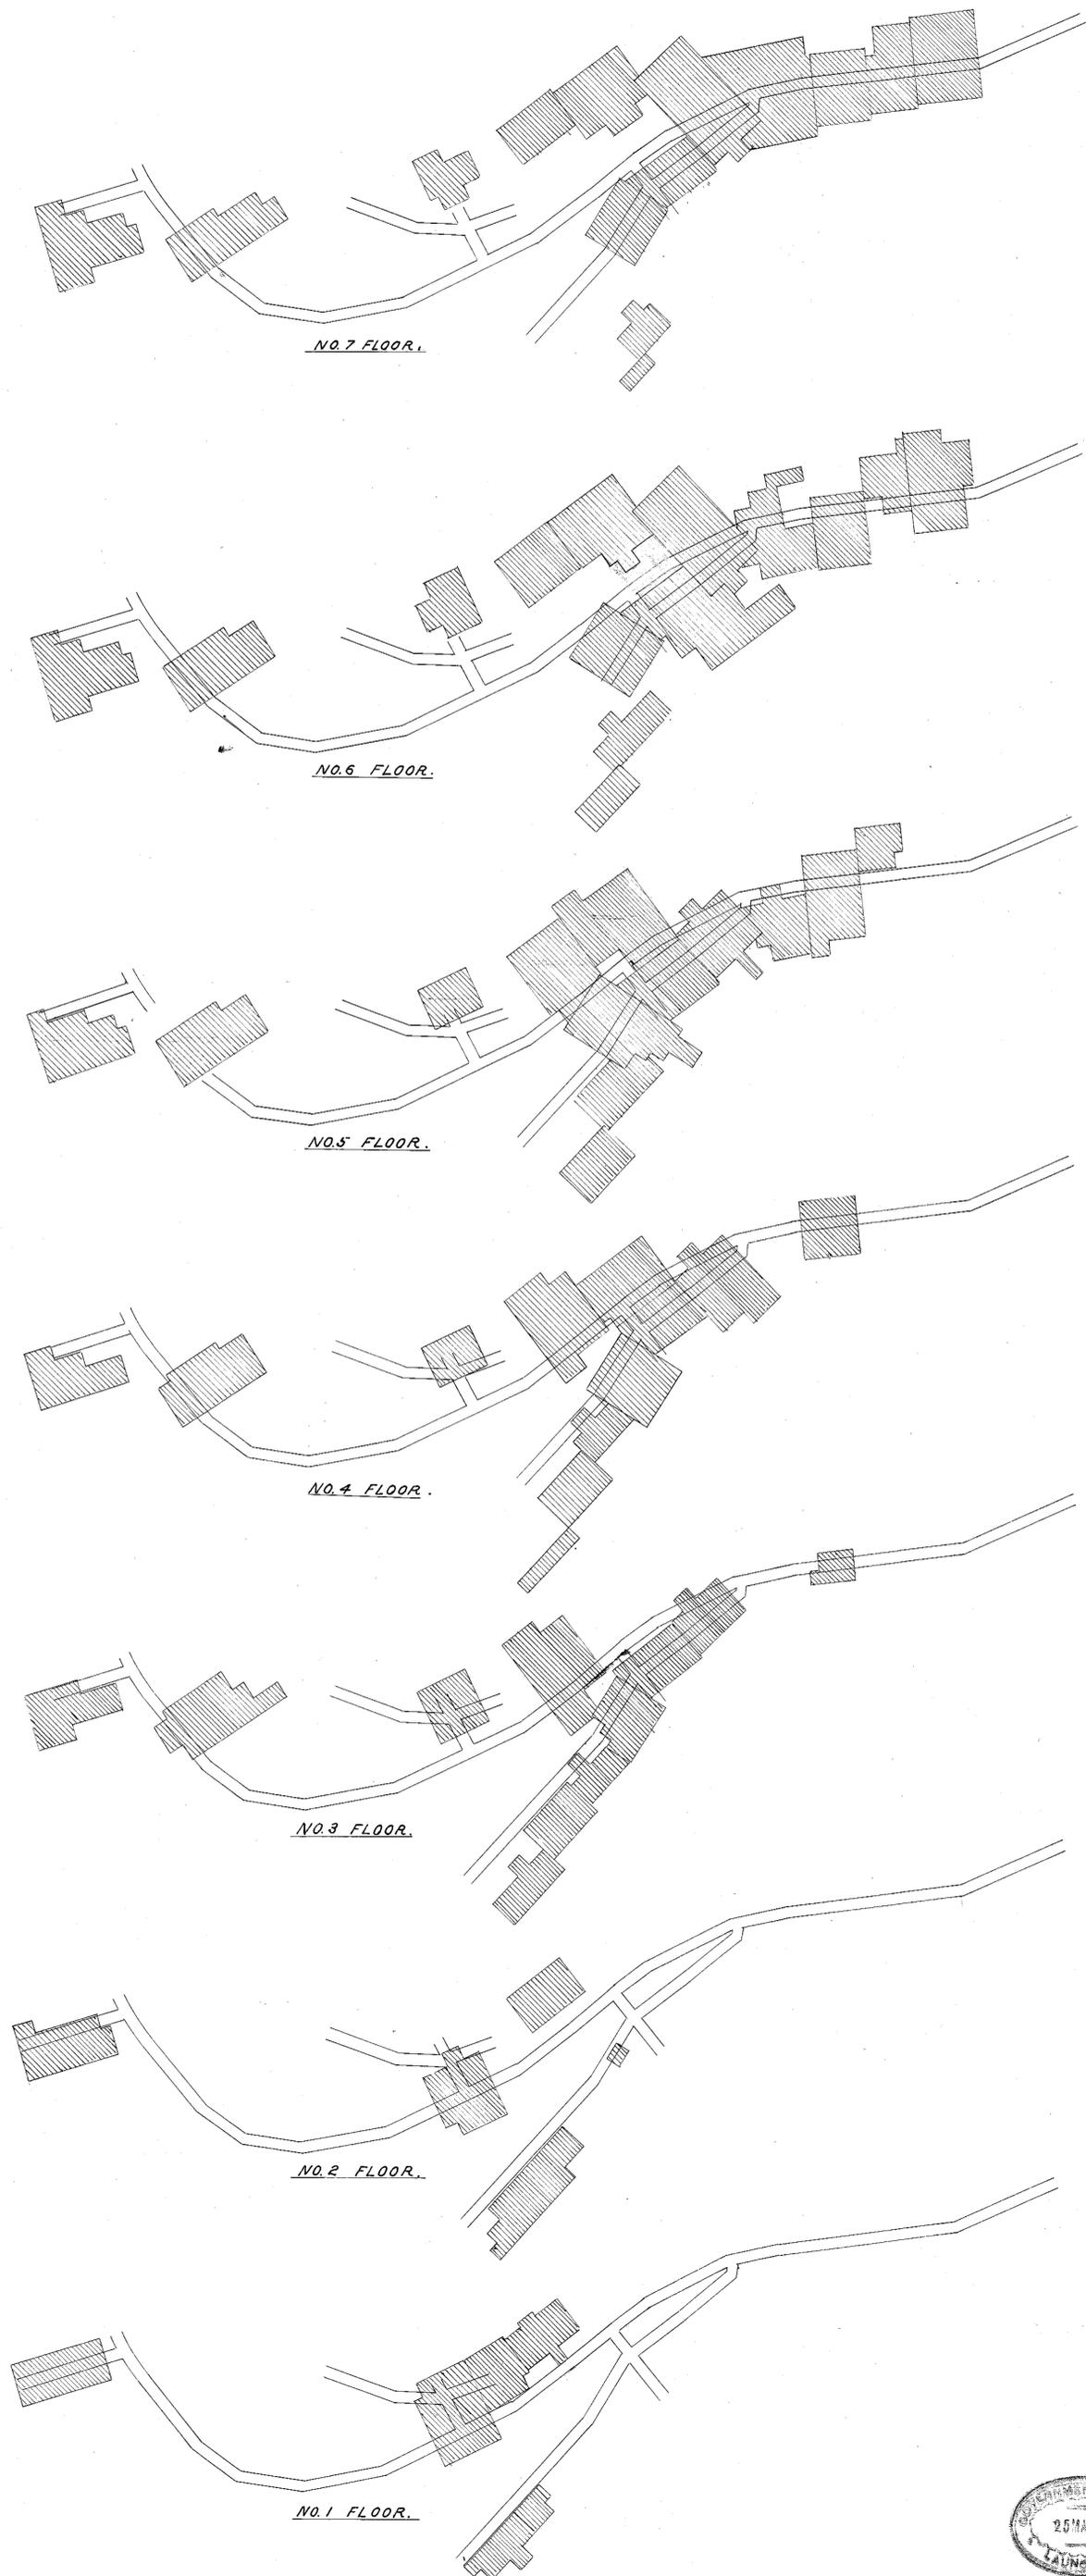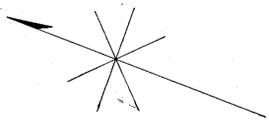

Floors 76' high

