


M^T LYELL BLOCKS M. CO. N.L.

LONGITUDINAL SECTION

Shewing workings projected on a plane parallel to Western Boundary.

Scale - 40 ft. to in.

Jno M. R. K. 24/1/06

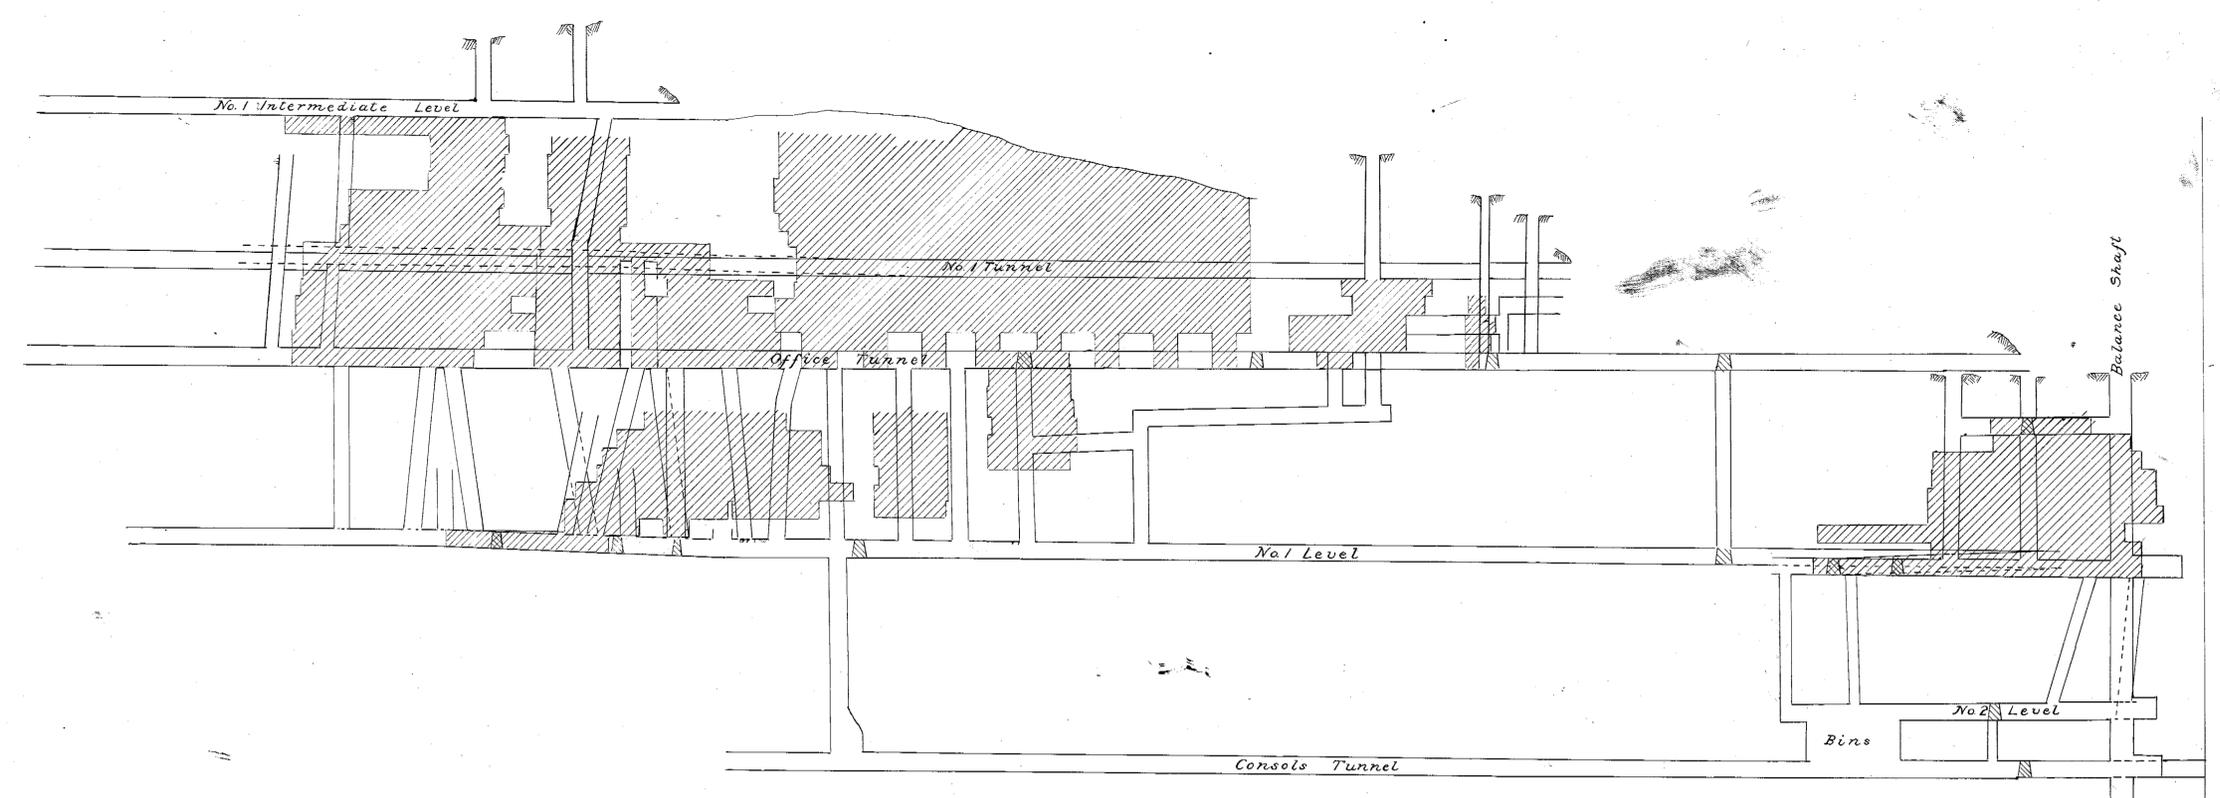

Stoping shewn thus 