


# ==== MOUNT LYELL BLOCKS COPPER MINES N.L. ====

==== PLAN Showing ADDITIONS to Dec. 31<sup>st</sup> 1918 ====

==== SCALE 40 Feet = 1 Inch ====

REFERENCE


1000 Ft. LEVEL	=====
1100 " "	=====
1300 " "	=====
INTERMEDIATE " 12-1300	=====

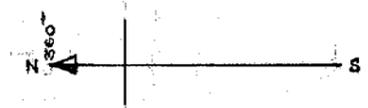

105-29

5 cm

105-29

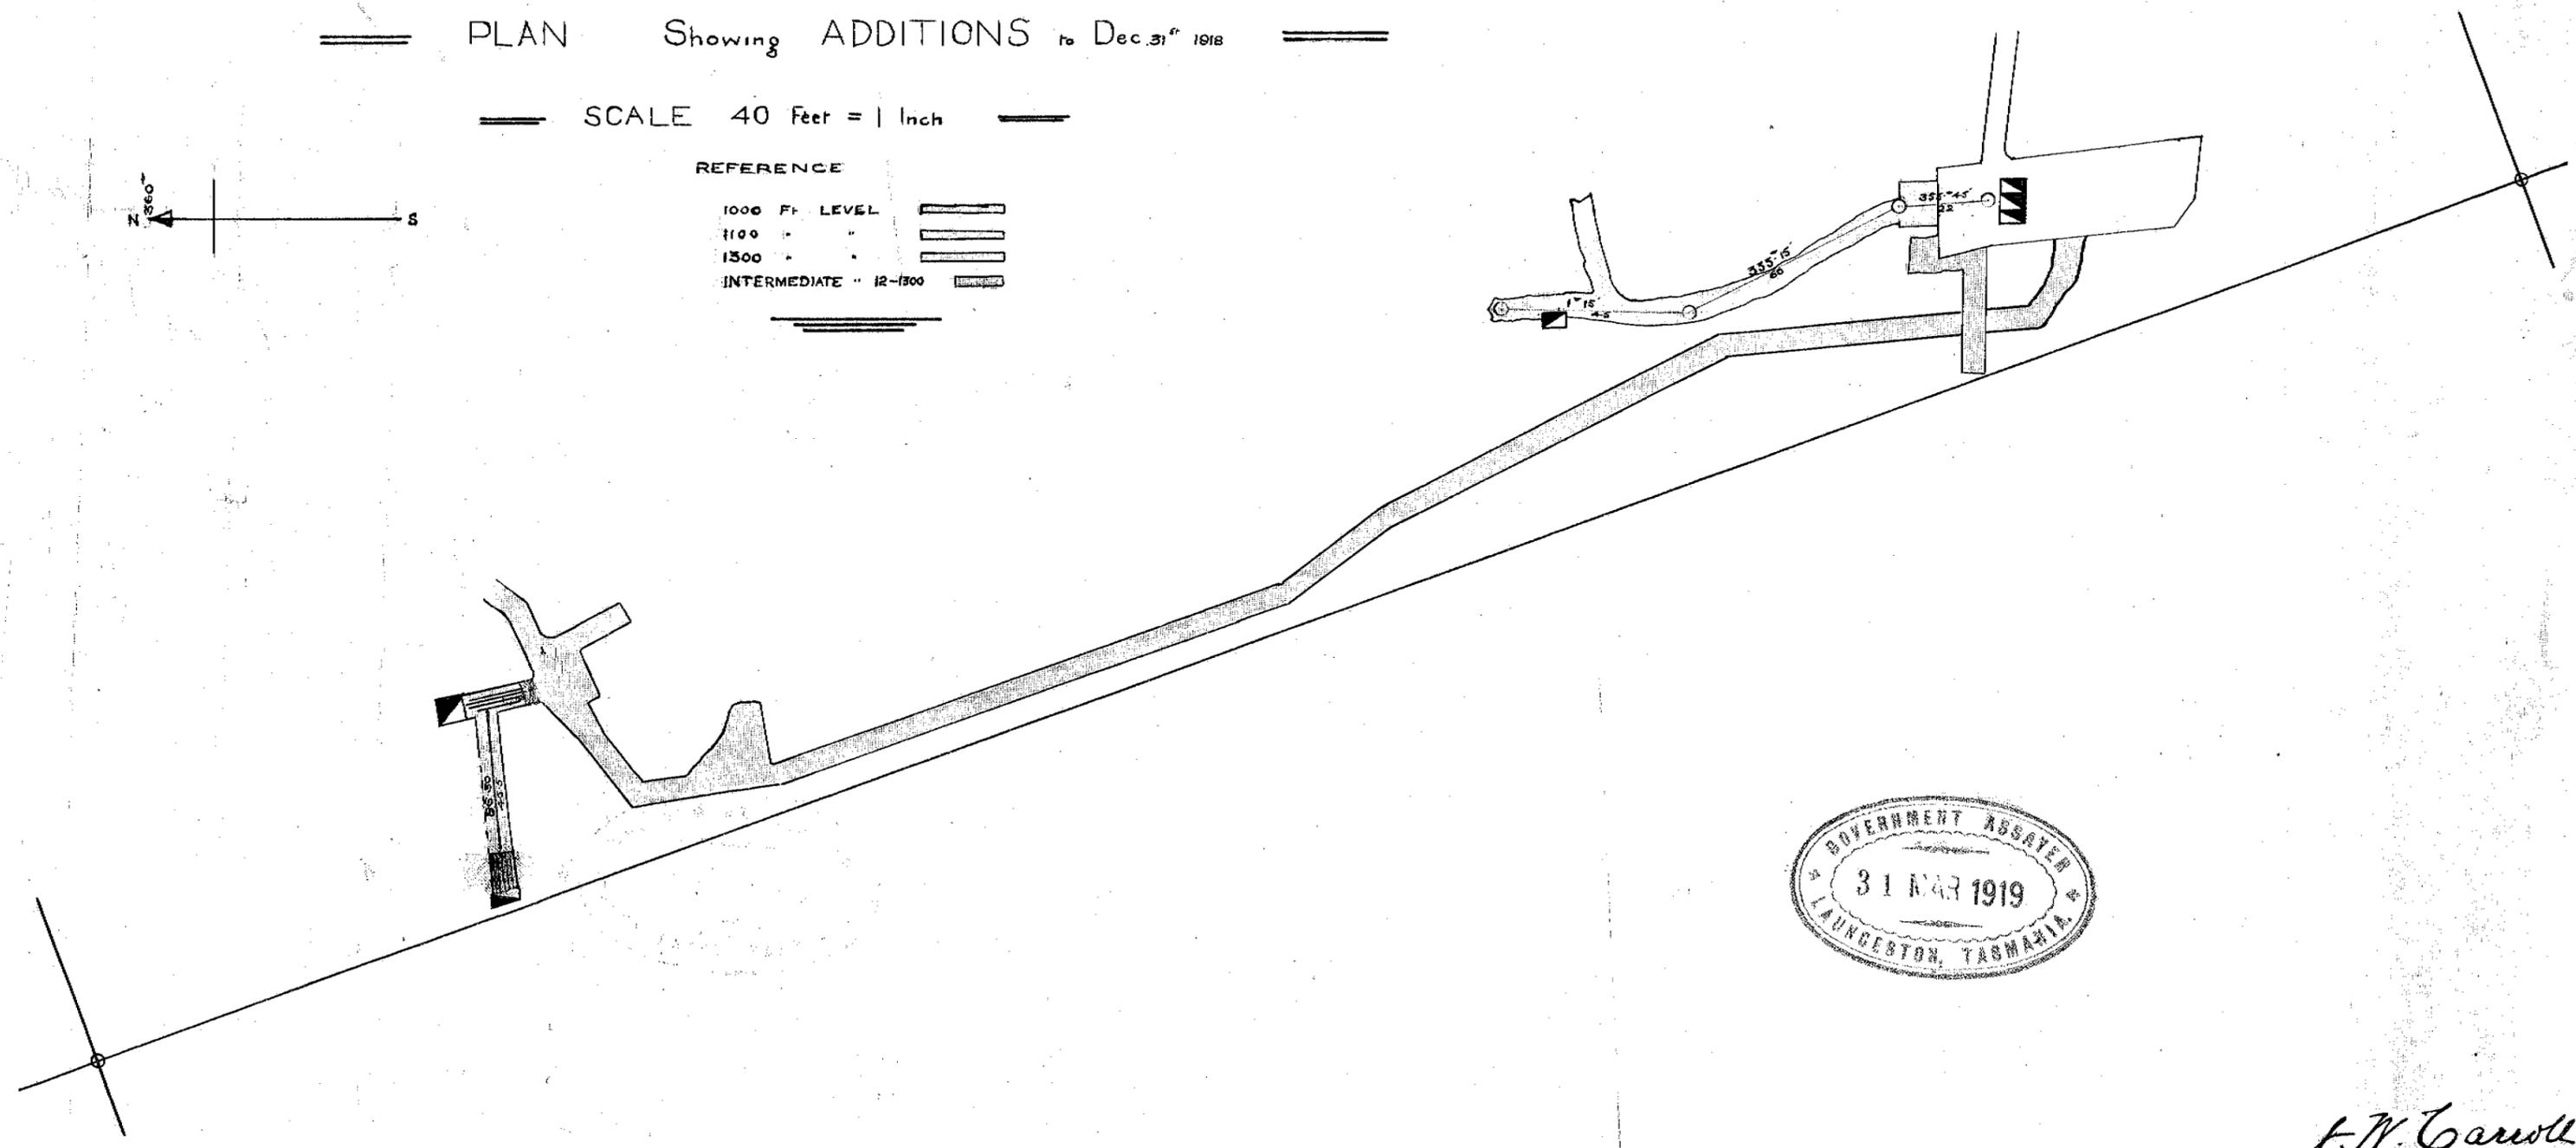

*J. W. Carroll*  
*mg*