



105-30

5 cm

105-30

1010
Blocks
15

Section on Line AA N^o 1 RISE 1300 LEVEL
SCALE 1 INCH = 40 FEET

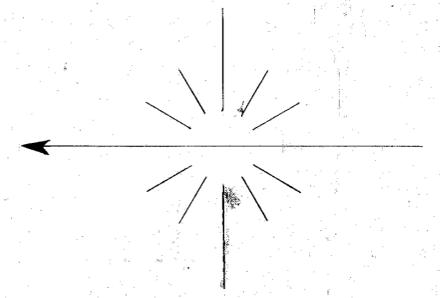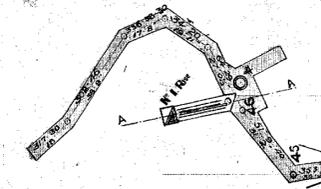

NORTH LYELL MINE

== MOUNT LYELL BLOCKS COPPER MINES ==

== PLAN OF ==

== UNDERGROUND WORKINGS ==

== SCALE 1 INCH = 40 FEET ==

== REFERENCE ==

- 1600 FT LEVEL
- 1500 FT .
- 1400 FT .
- 1300 FT .
- BOREHOLES

== Instrument Used 5" TRANSIT THEODOLITE ==

== FEB 26 1917 ==

J.M. Ansell
H. Ansell

