


105-31

5 cm

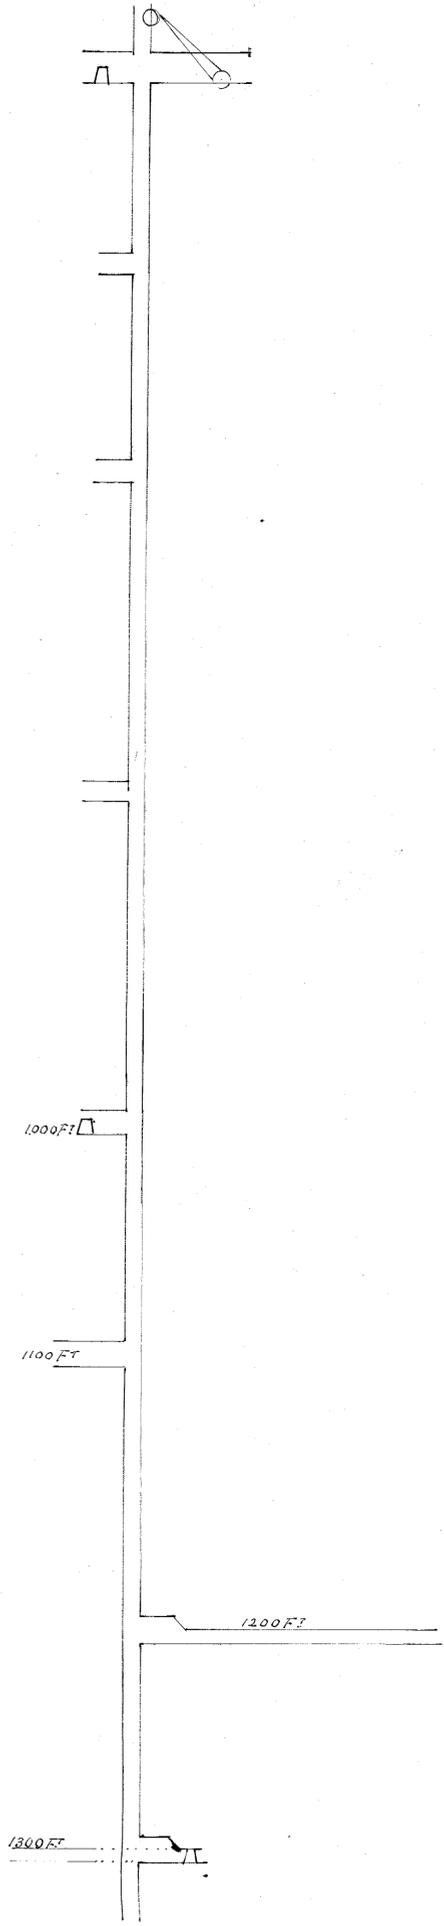

M^r LYELL BLOCKS COPPER MINES NO LIA:

SECTION

SCALE 1" = 40 FEET

J. W. Carroll
30/5/16