


OFFICE TUNNEL STOPES

Scale 40' to 1"

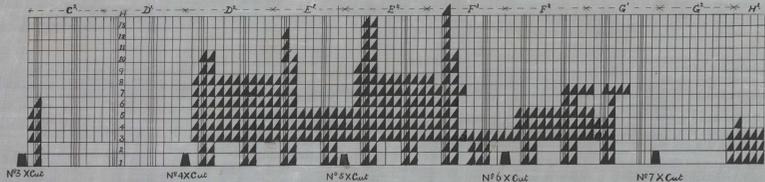

SECTION
Sloped from [shaded] to [unshaded] shows this
Manways - - - - -

N°1 FLOOR

N°2 FLOOR

N°3 FLOOR

N°4 FLOOR

N°5 FLOOR

N°6 FLOOR

N°7 FLOOR

N°8 FLOOR

N°9 FLOOR

N°10 FLOOR

N°11 FLOOR

N°12 FLOOR

N°13 FLOOR

N°14 FLOOR

0105-34

0105-34

119