


MT LYELL CONSOLS COPPER MINES N L

PLAN OF WORKINGS

Scale One Inch = 40 Feet

M.C. 31-12-09

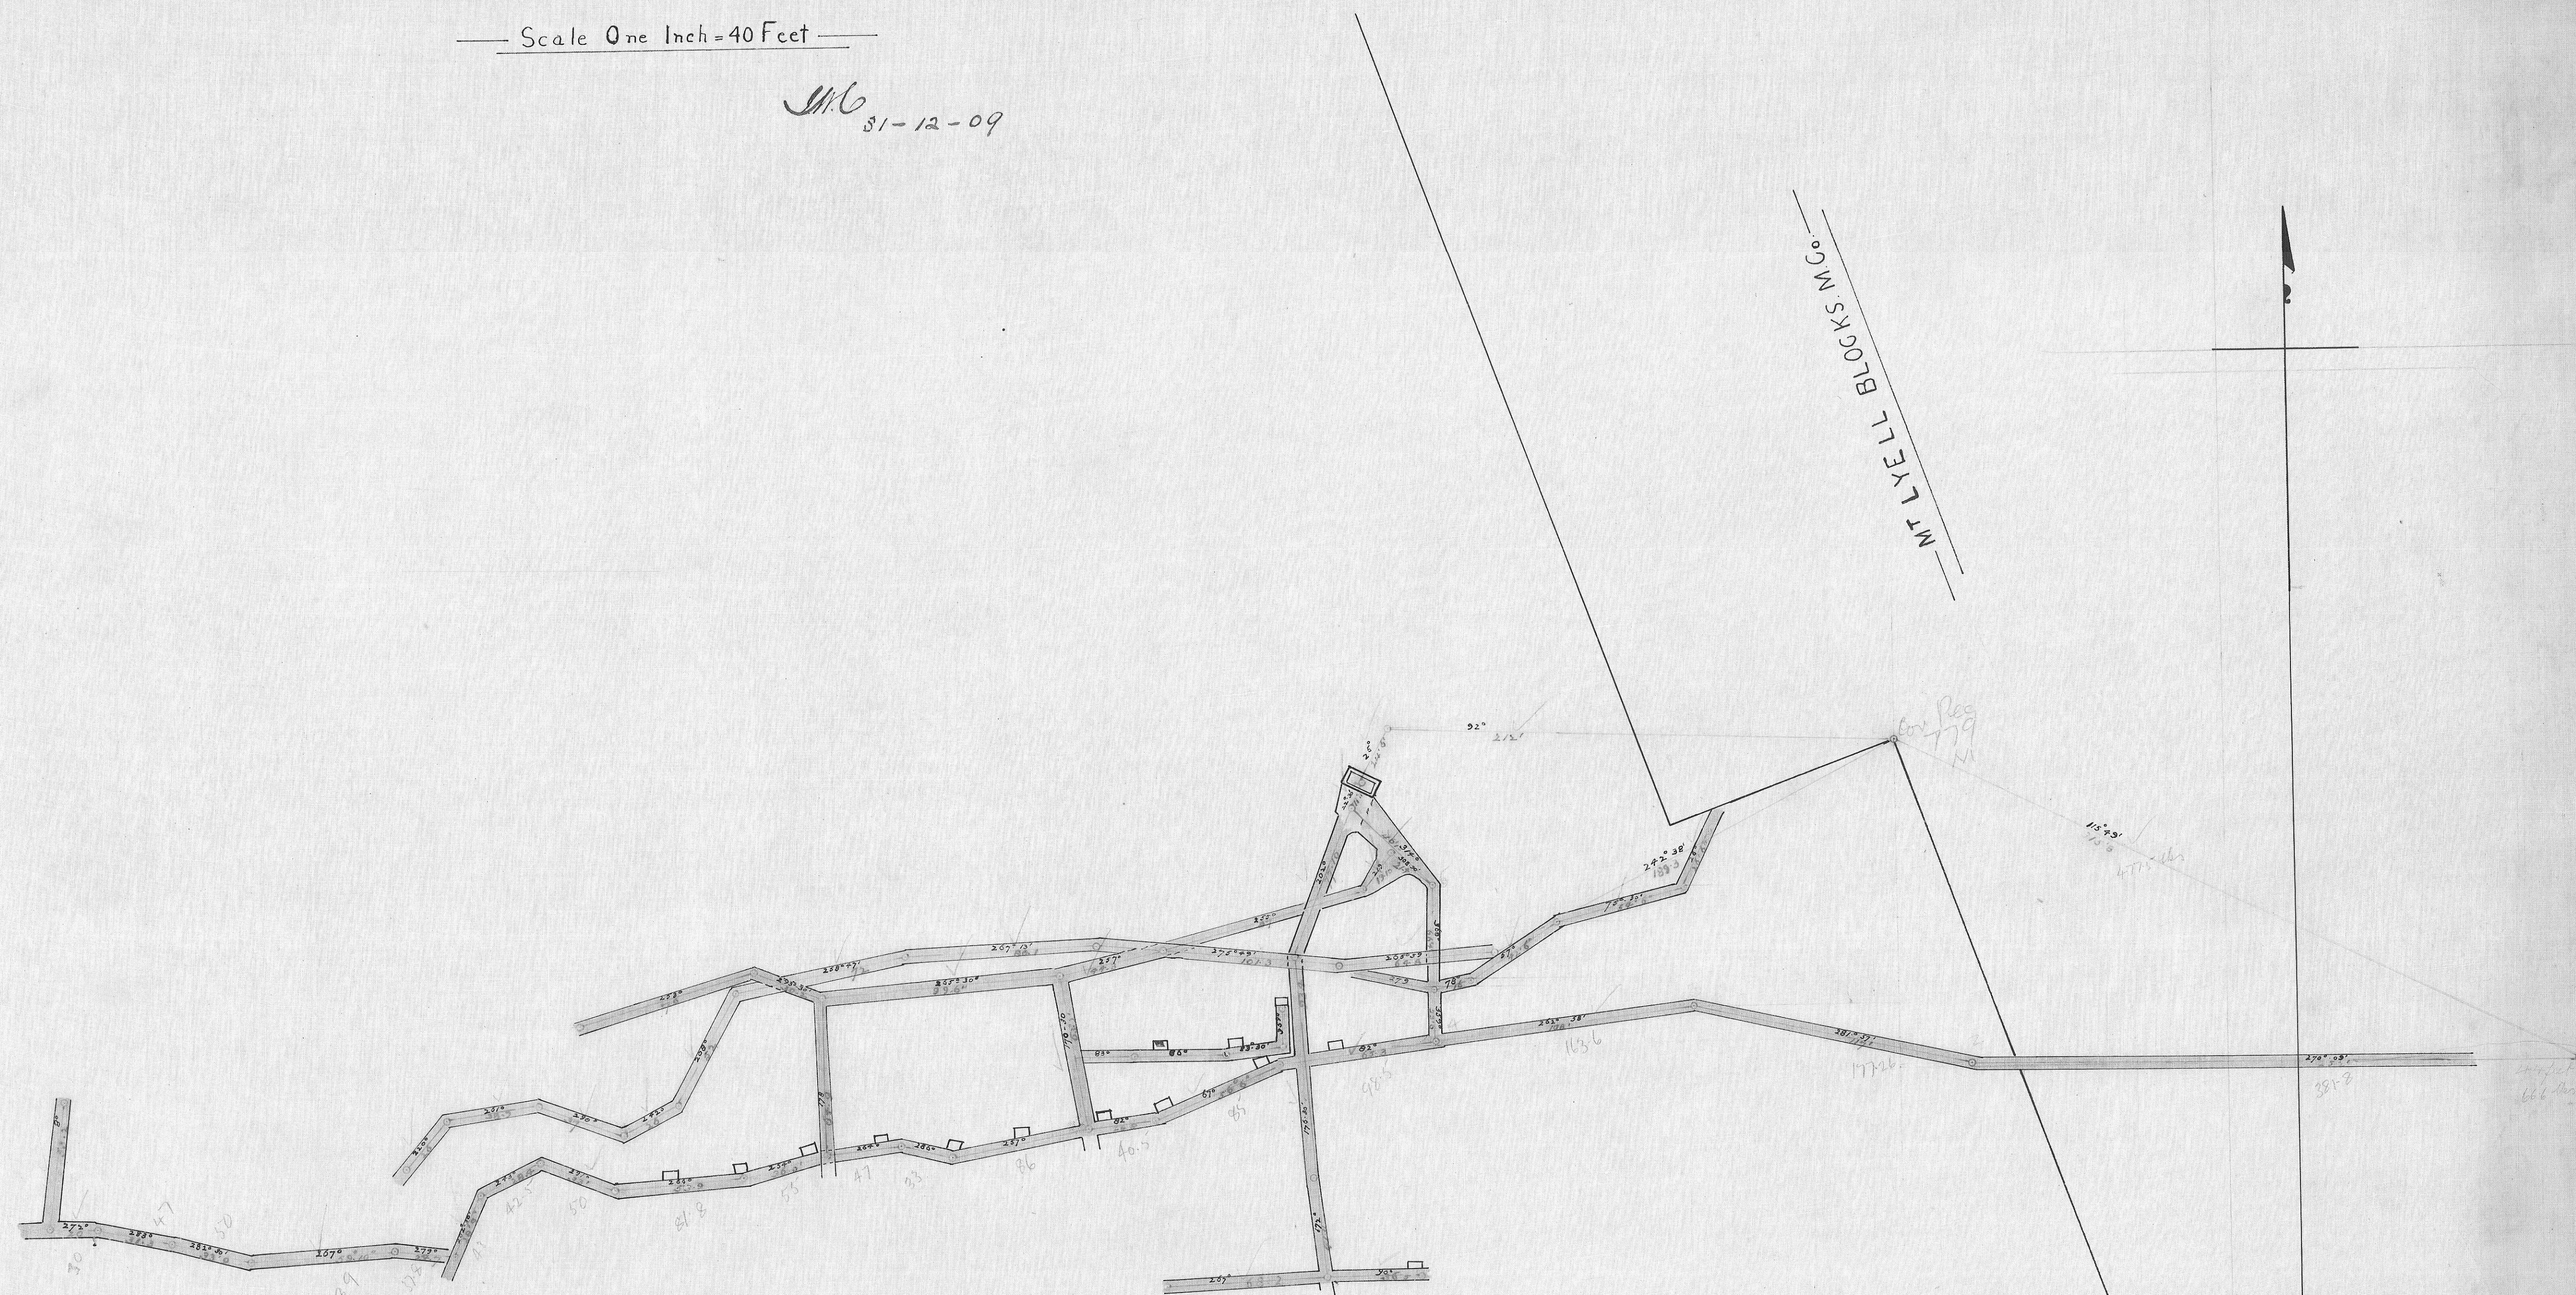

References

Tram Adit	
No. 1 Level	
No. 2 Level	
Rises	

MT LYELL EXT'D

MT LYELL BLOCKS M.C.



5 cm

106-01

135