

106-02

5 cm

LYELL THARSIS

2/05
915
89

MT LYELL CONSOLS

MT LYELL CONSOLS


1/18
91

Main Tunnel

Datum of Bearings

MT LYELL CONSOLS MC COUnderground Survey to end of 189825 Feet to an Inch.Extensions to end March 1901
as shown in Blue

W. M. Sackman
 Asst. Surveyor
 8/4/1901

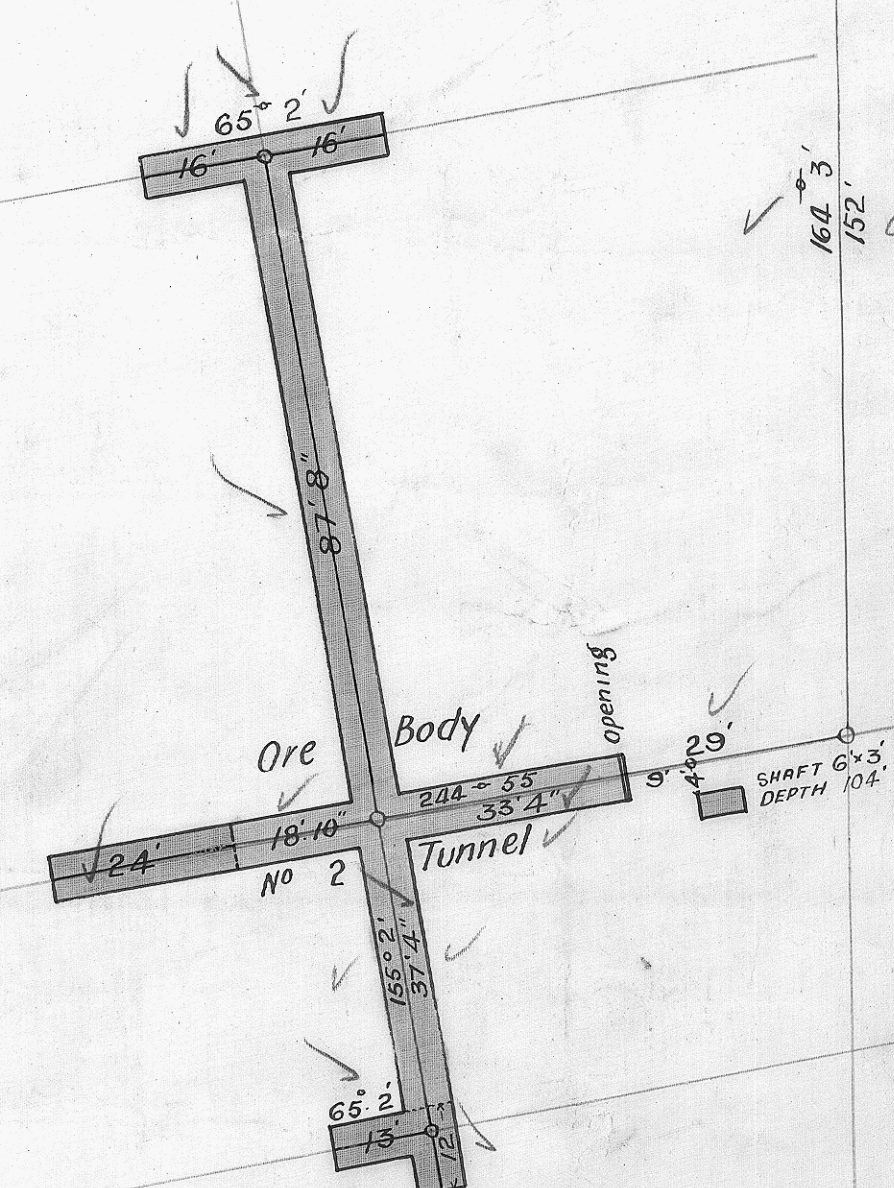

MT LYELL CONSOLS

1/16
91