


# MT LYELL CONSOLS COPPER MINES.N.L

## LONGITUDINAL SECTION

Scale One Inch = 40 Feet

*J. W. Carroll 30-9-10*

Mount Lyell Block M Co

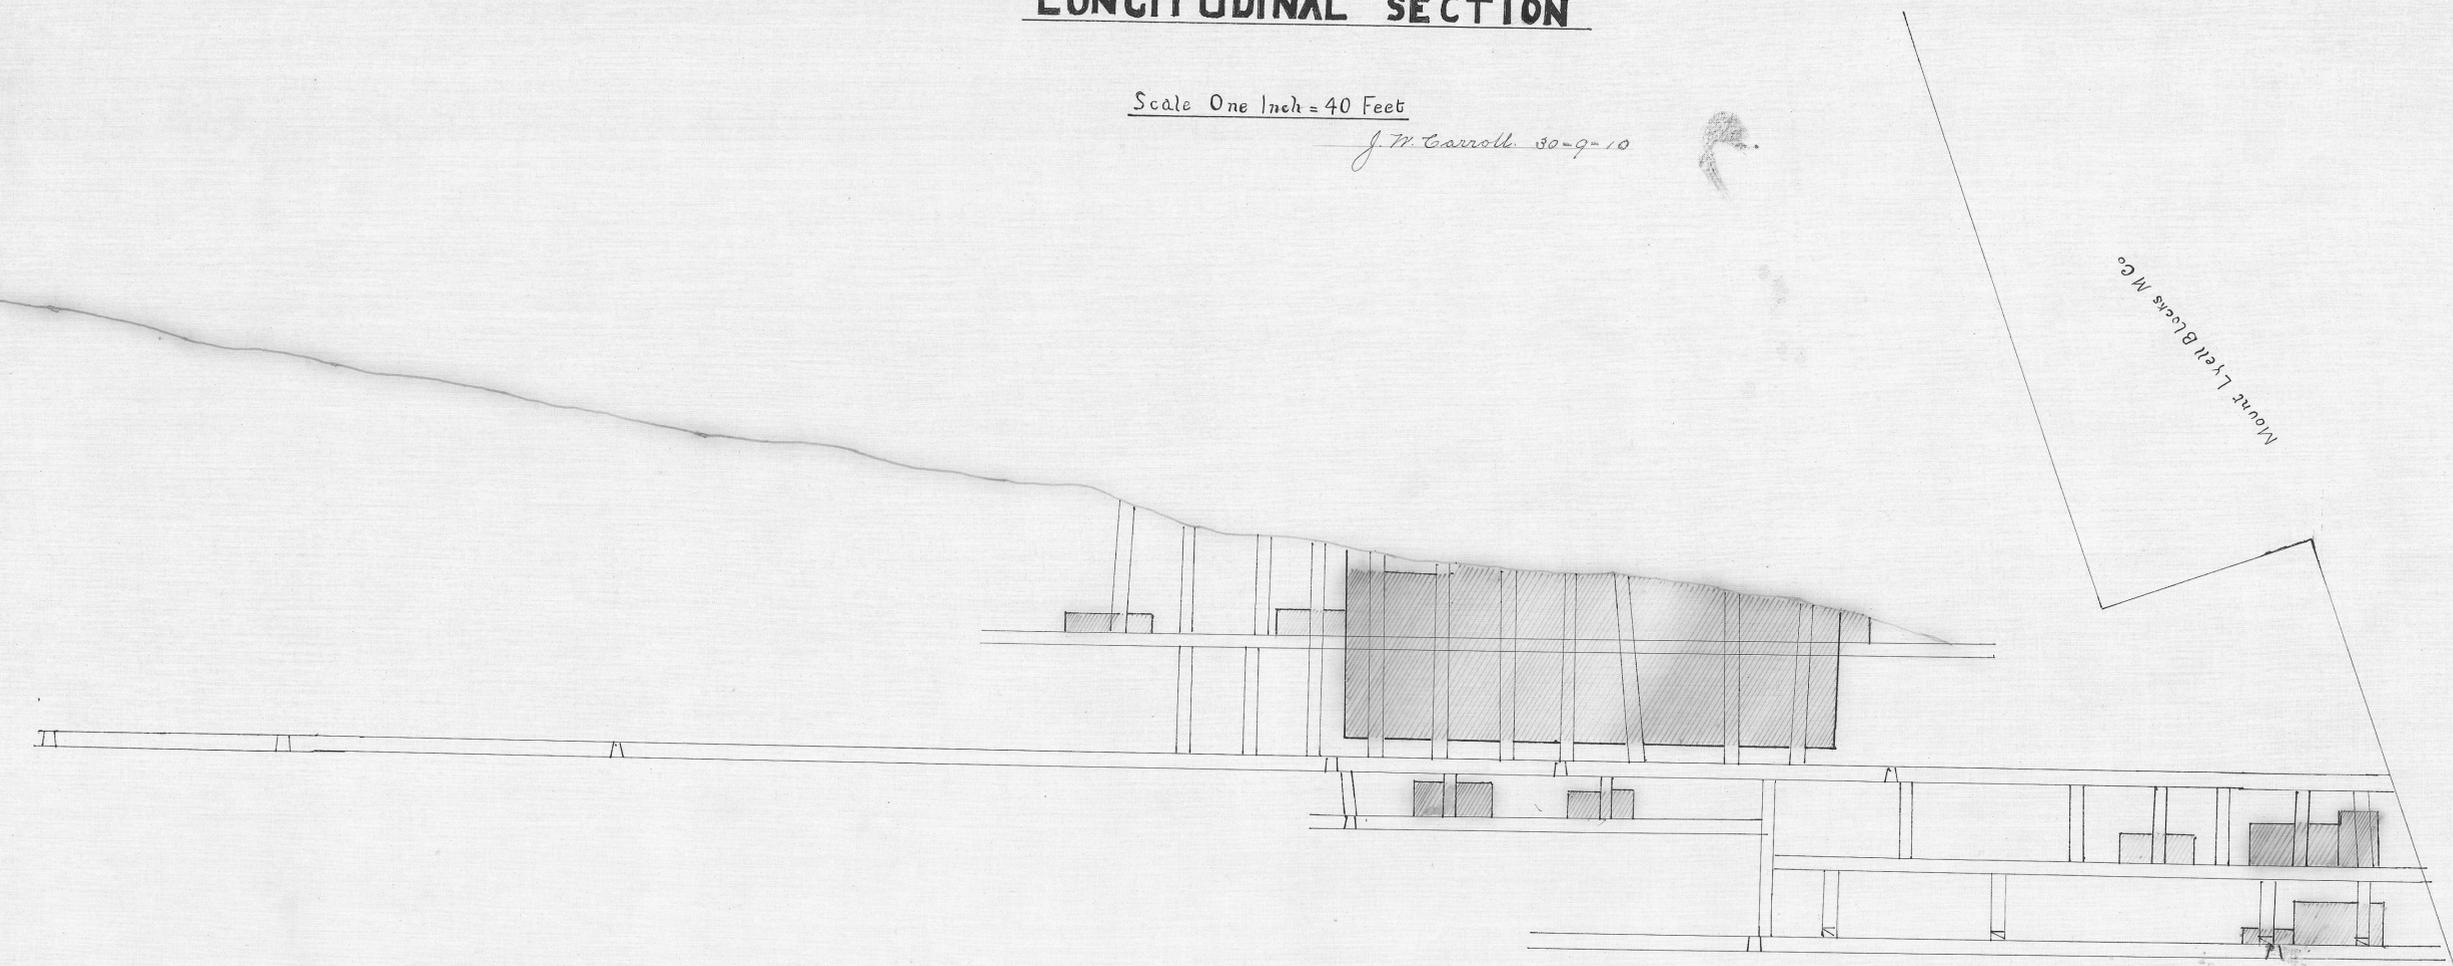

106-03

5 cm

106-03

MT LYELL EXTENDED