


106-09

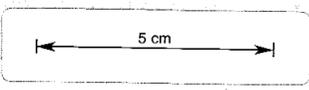

M^T LYELL CONSOLS M^C C^O

Underground Survey For 1898

Scale 25 Feet to an Inch

February 1898

J. J. Ellwri
Author of Survey
- Feb. 99.




CONSOLS
 $\frac{5}{89}$

CONSOLS
 $\frac{117}{91}$

CONSOLS
 $\frac{116}{91}$

144' 0" 75° Datum of Bearings

164' 3" 152' 0"

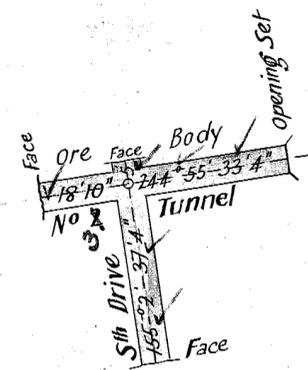

Magnetic North

4
17707 1898
1100'

40

40