

106-10



Mount Lyell Consols Mining Co. N. L.
No. 101 - 1010

MOUNT LYELL CONSOLS MINING CO. N. L.

PLAN OF WORKINGS

Scale - Forty ft. to an inch

Geo. McCauley
12/3/07

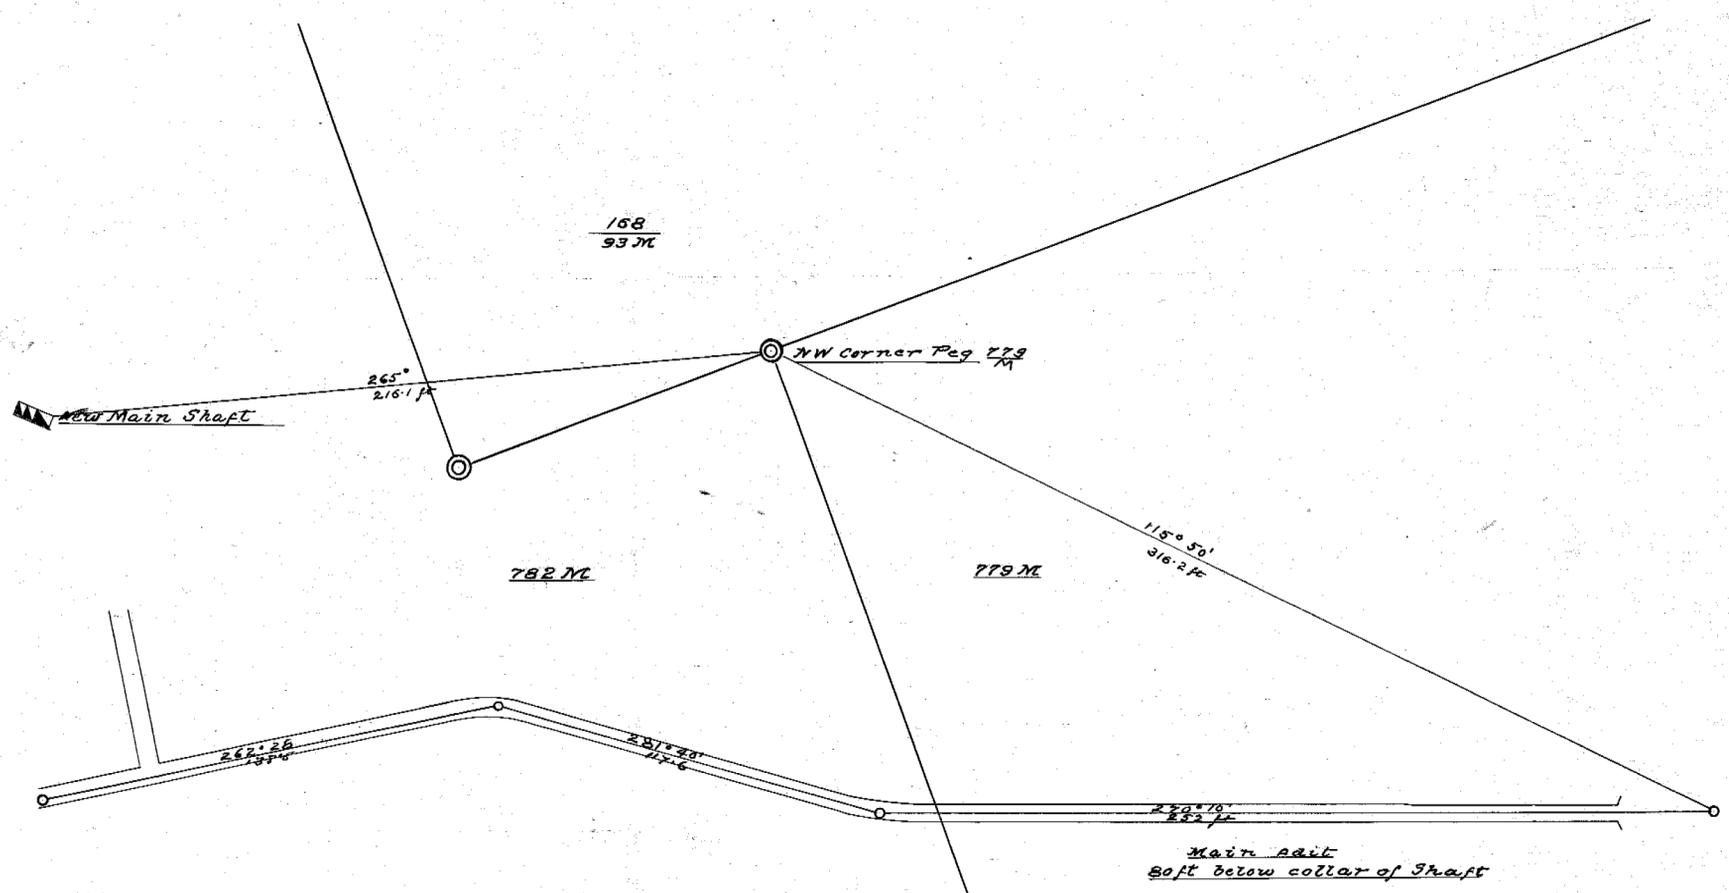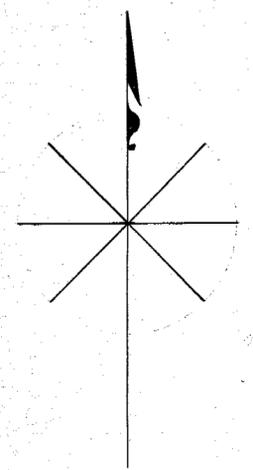

137