

107-02

5 cm




United Chums Gold Mining Company Ground Plan

Scale 4 in to 100 ft

I hereby certify this
to be a correct copy of my plan *Thos Wyatt*
Miner

REFERENCE
DRIVER
SHAFT
REEF
ROAD, WORK

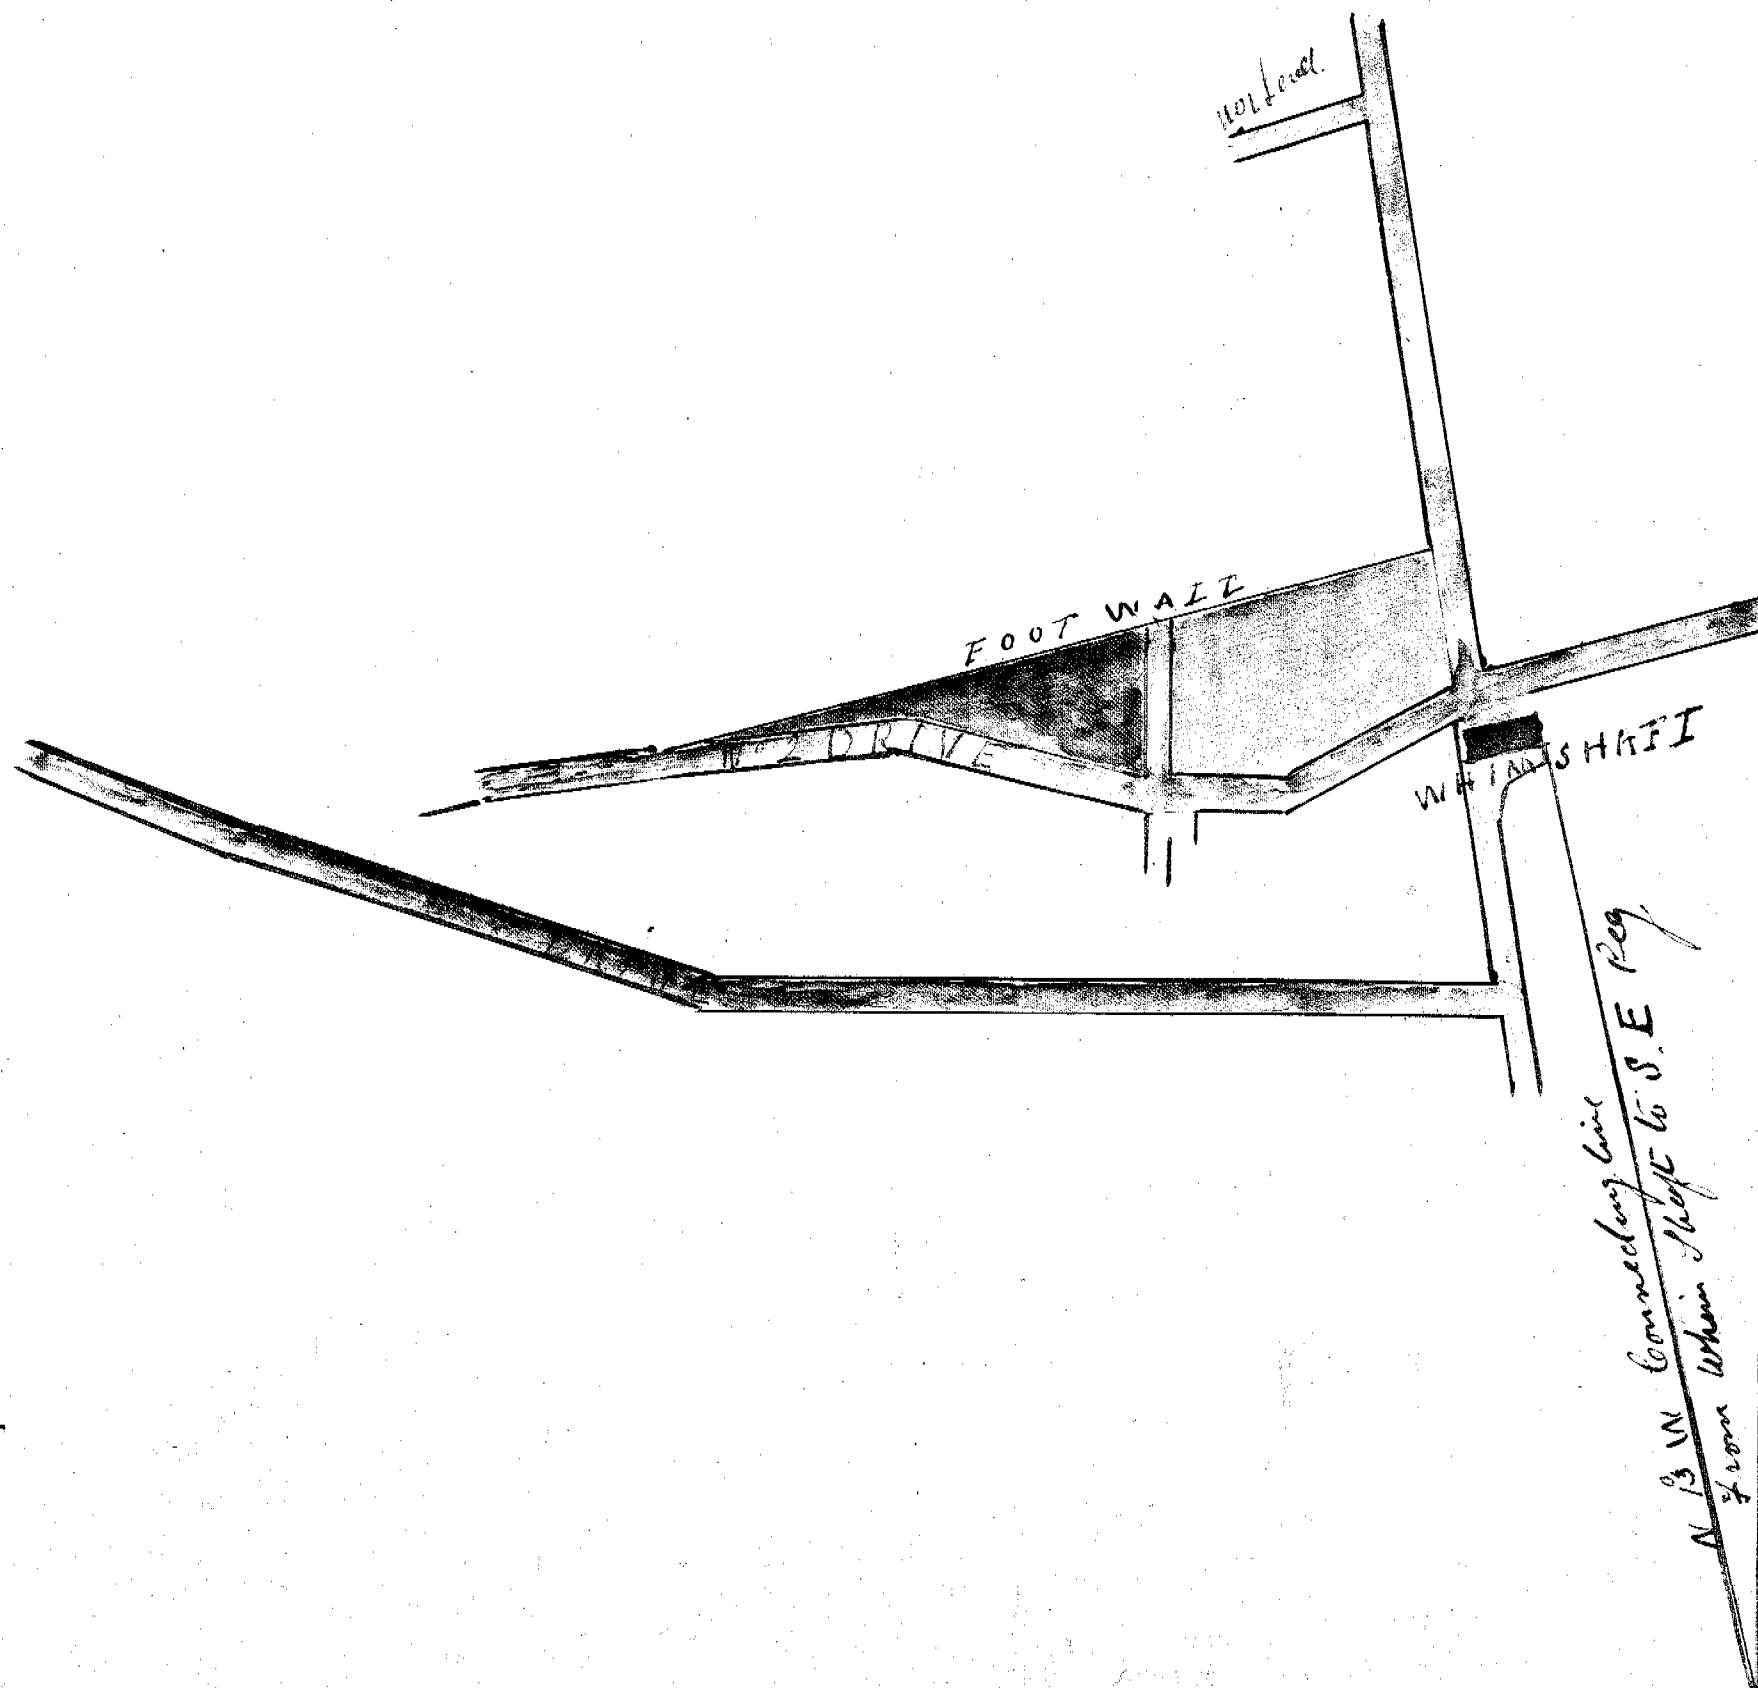

MAIN SHAFT