

07-03


REFERENCE
 REEF 
 SHAFT 
 DRIVES 
 SURFACE 

United Chums G.M. Co.
 I hereby certify this to
 be a correct copy of my plan for
 Mining Managers

(Scale) 1:22'

Surface line

Cross
 Section
 Scale 1 in to 100 ft

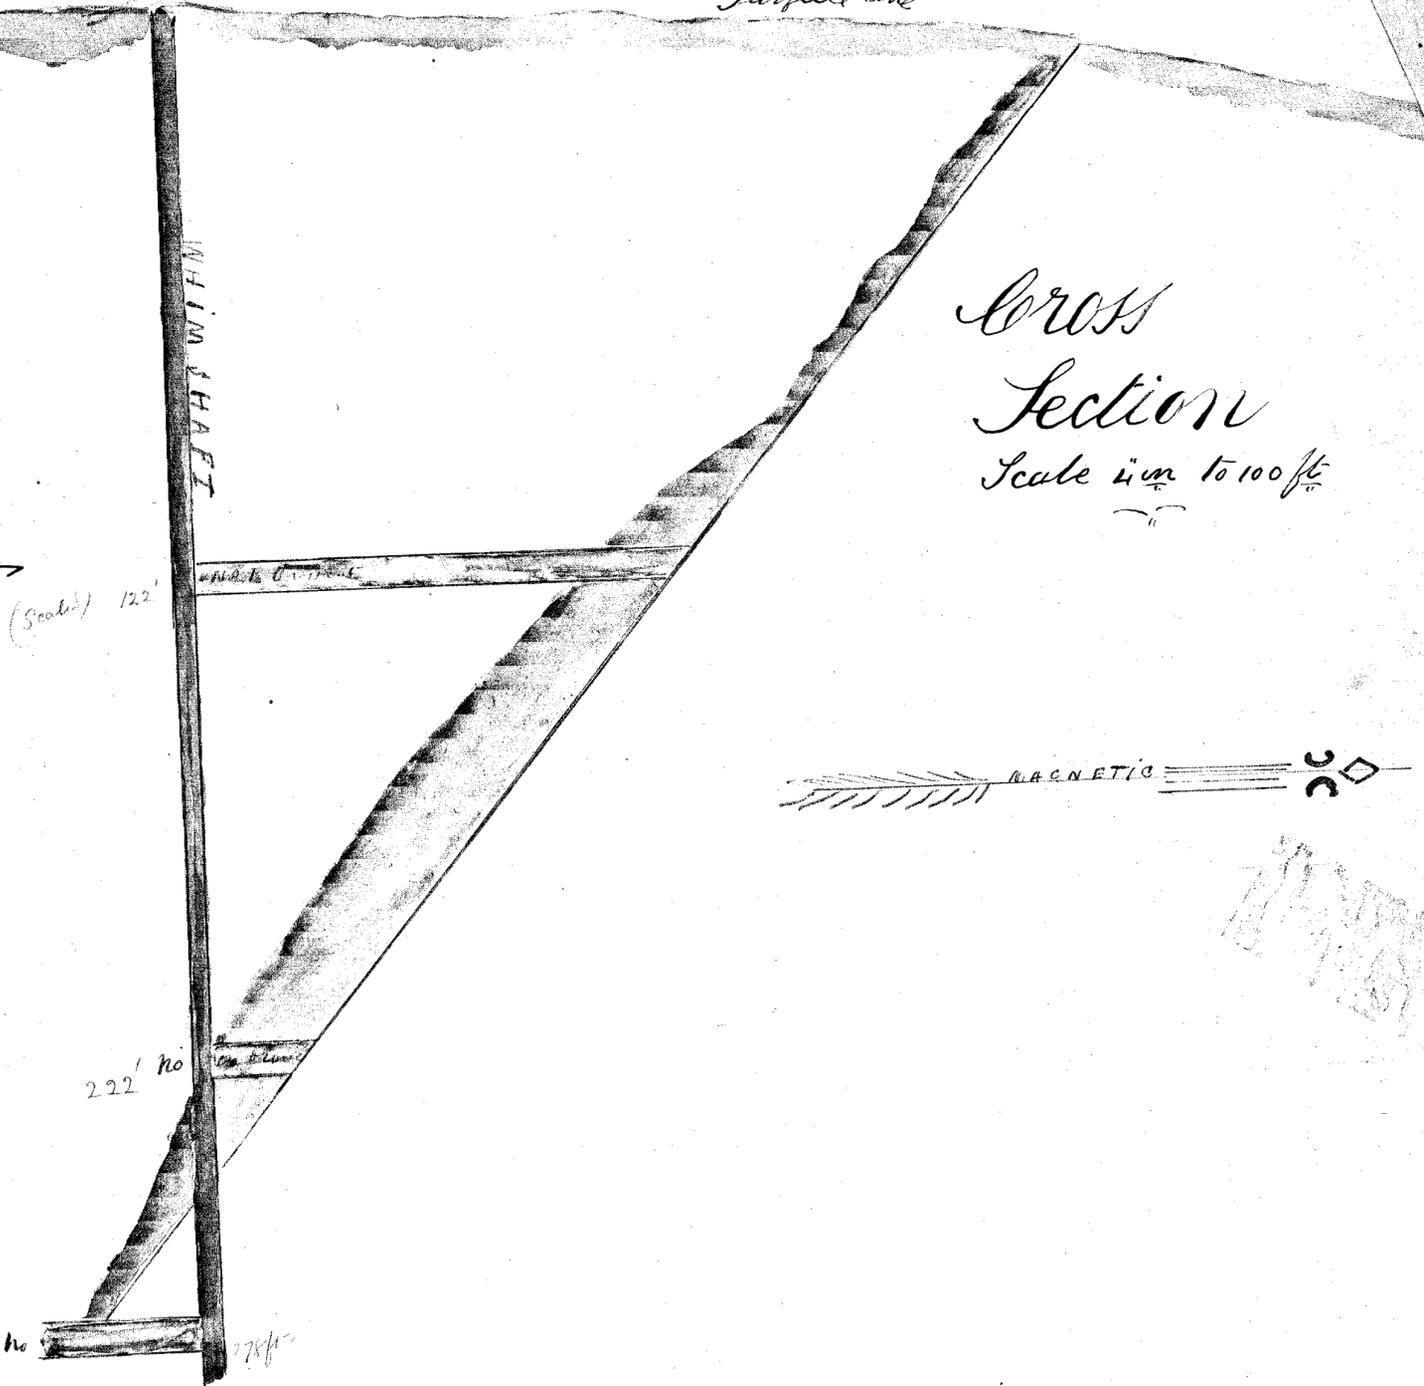

5 cm

07-03