


*Unity G. M.
Longitudinal Sec^{tn}*

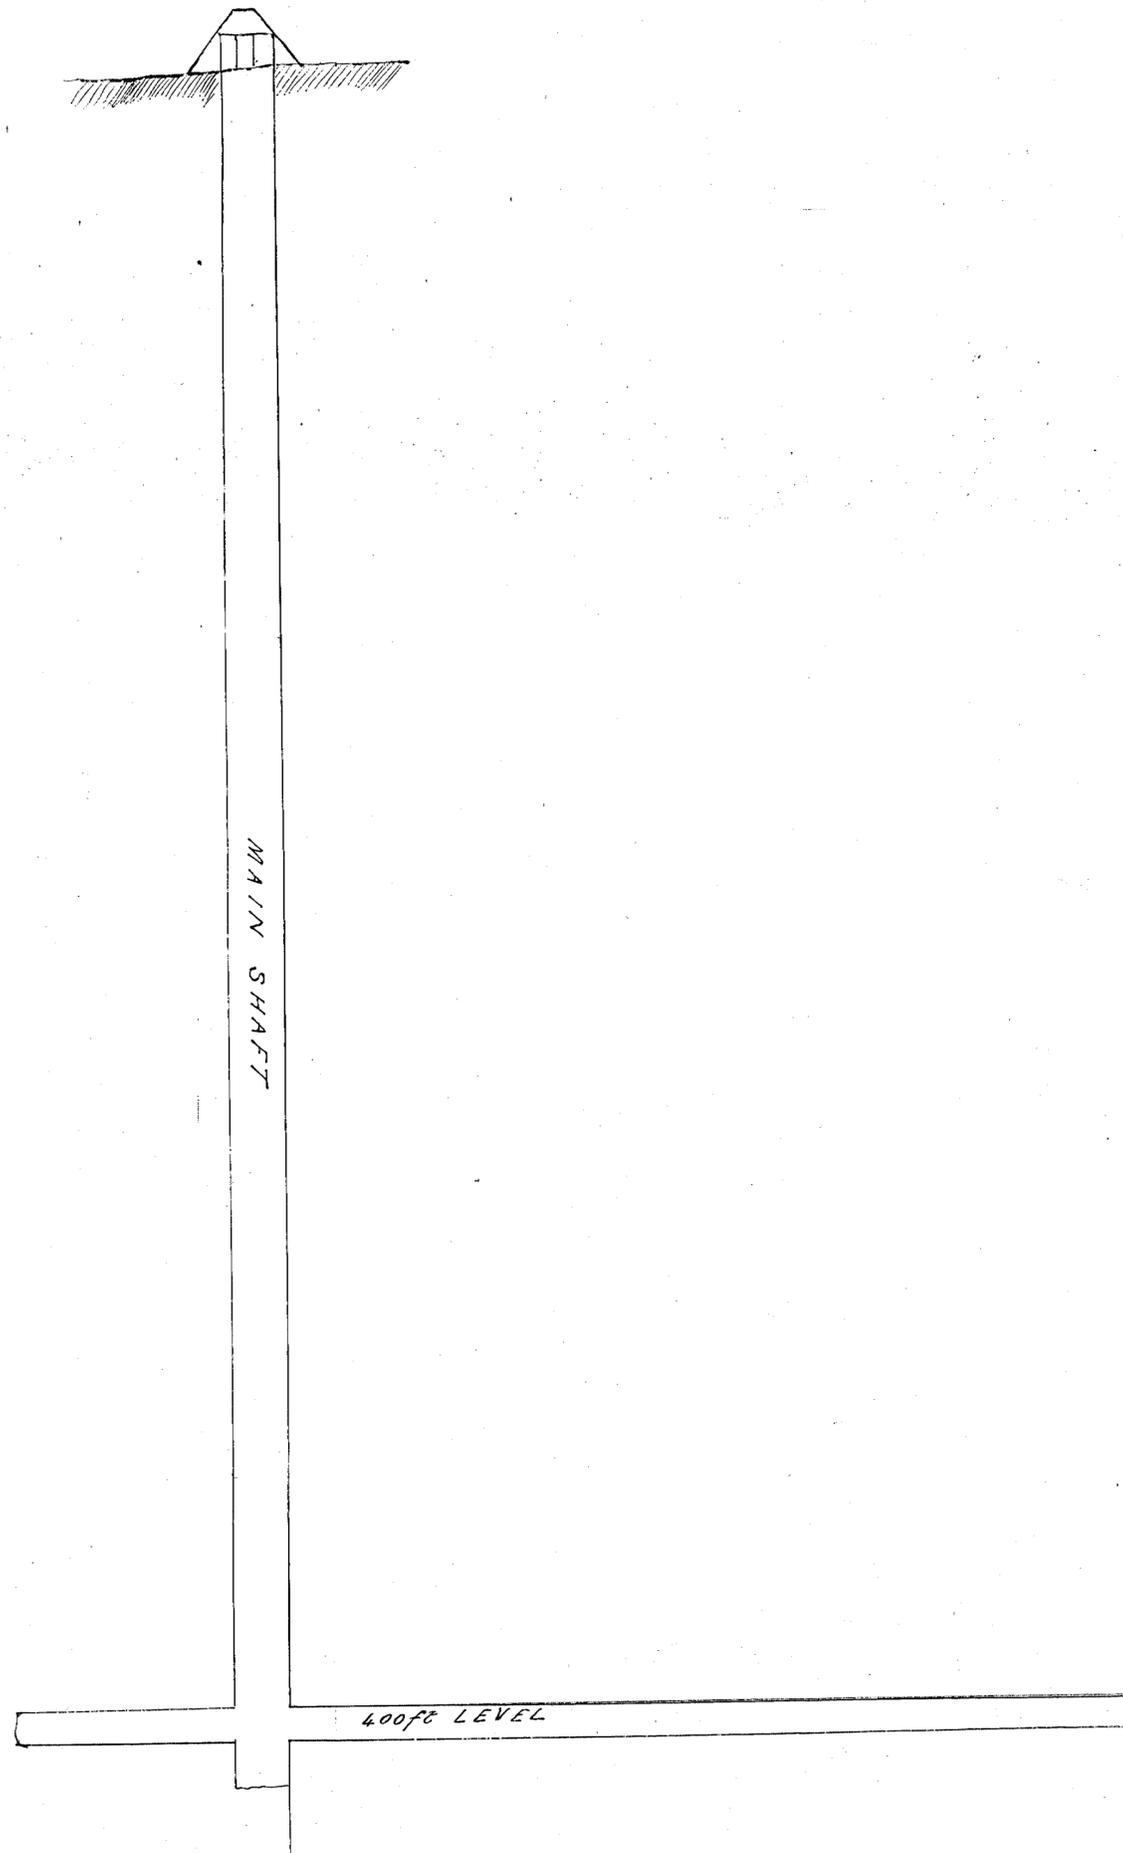

*Certified correct copy
of work done during 1890
C. P. Ripley, Waterbury
Mining Survey*

5 cm
70-80

70-80