


108-05

CROSS SECTION

5 cm

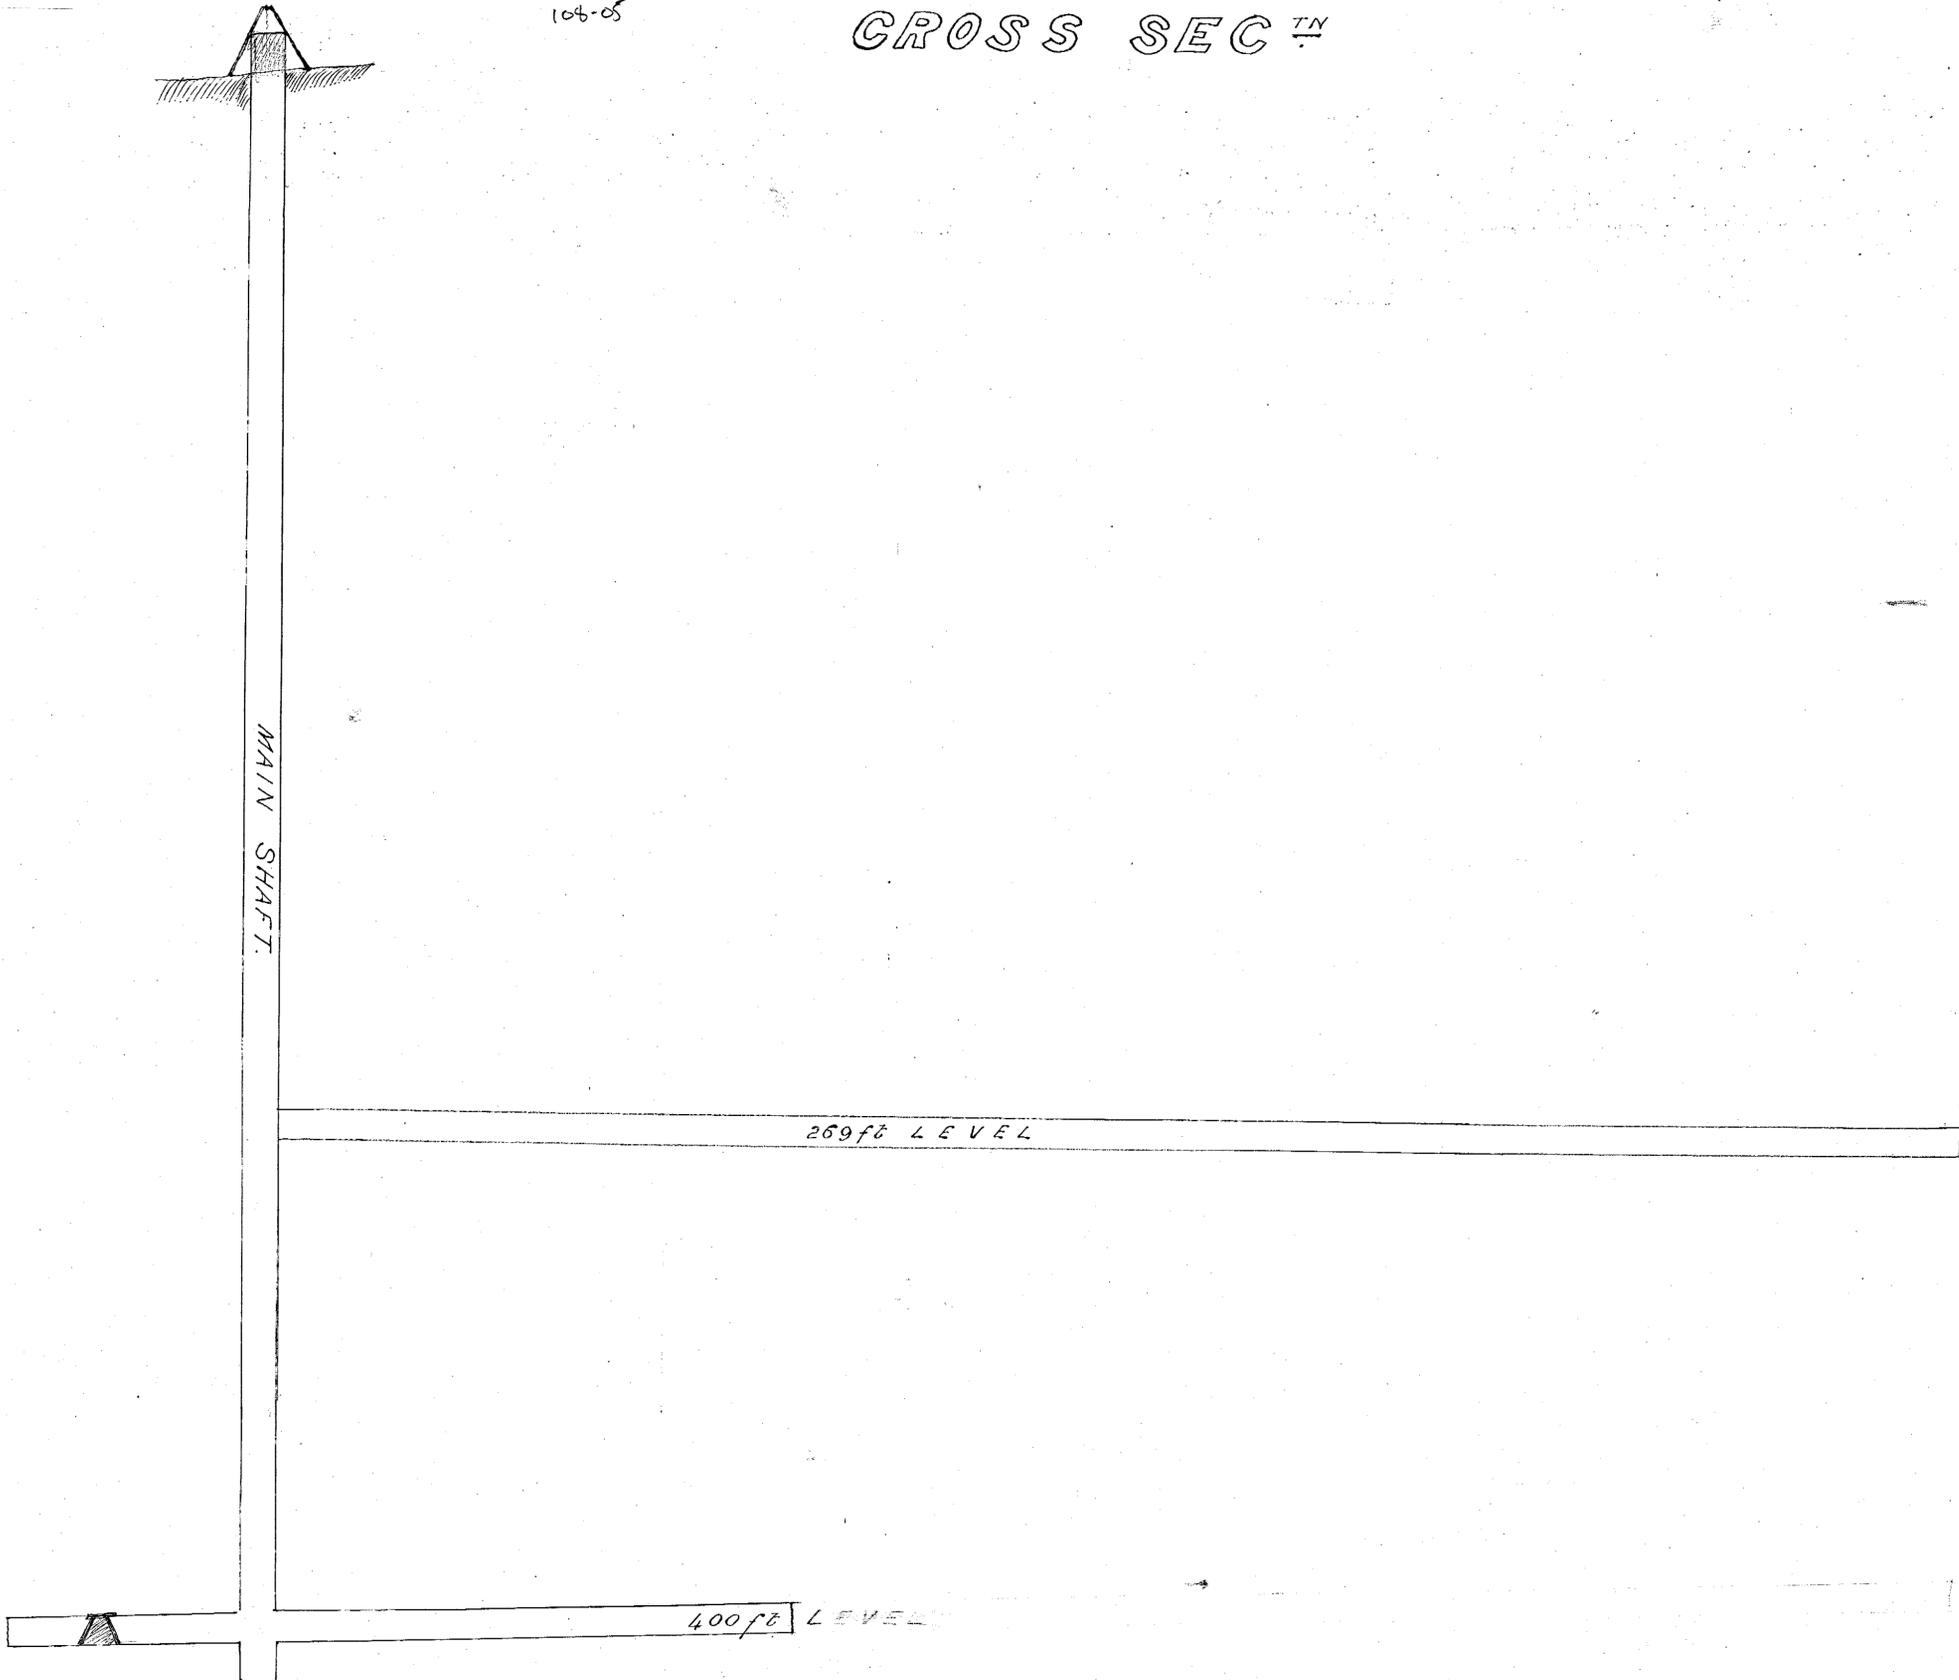

Certified correct
 copy of cross section
 for year 1890
 E. Quigley
 Mining & Fuel
 Survey