




185

109-01

109-01

NEW MONARCH G.M.

Scale 25ft to 1 inch.

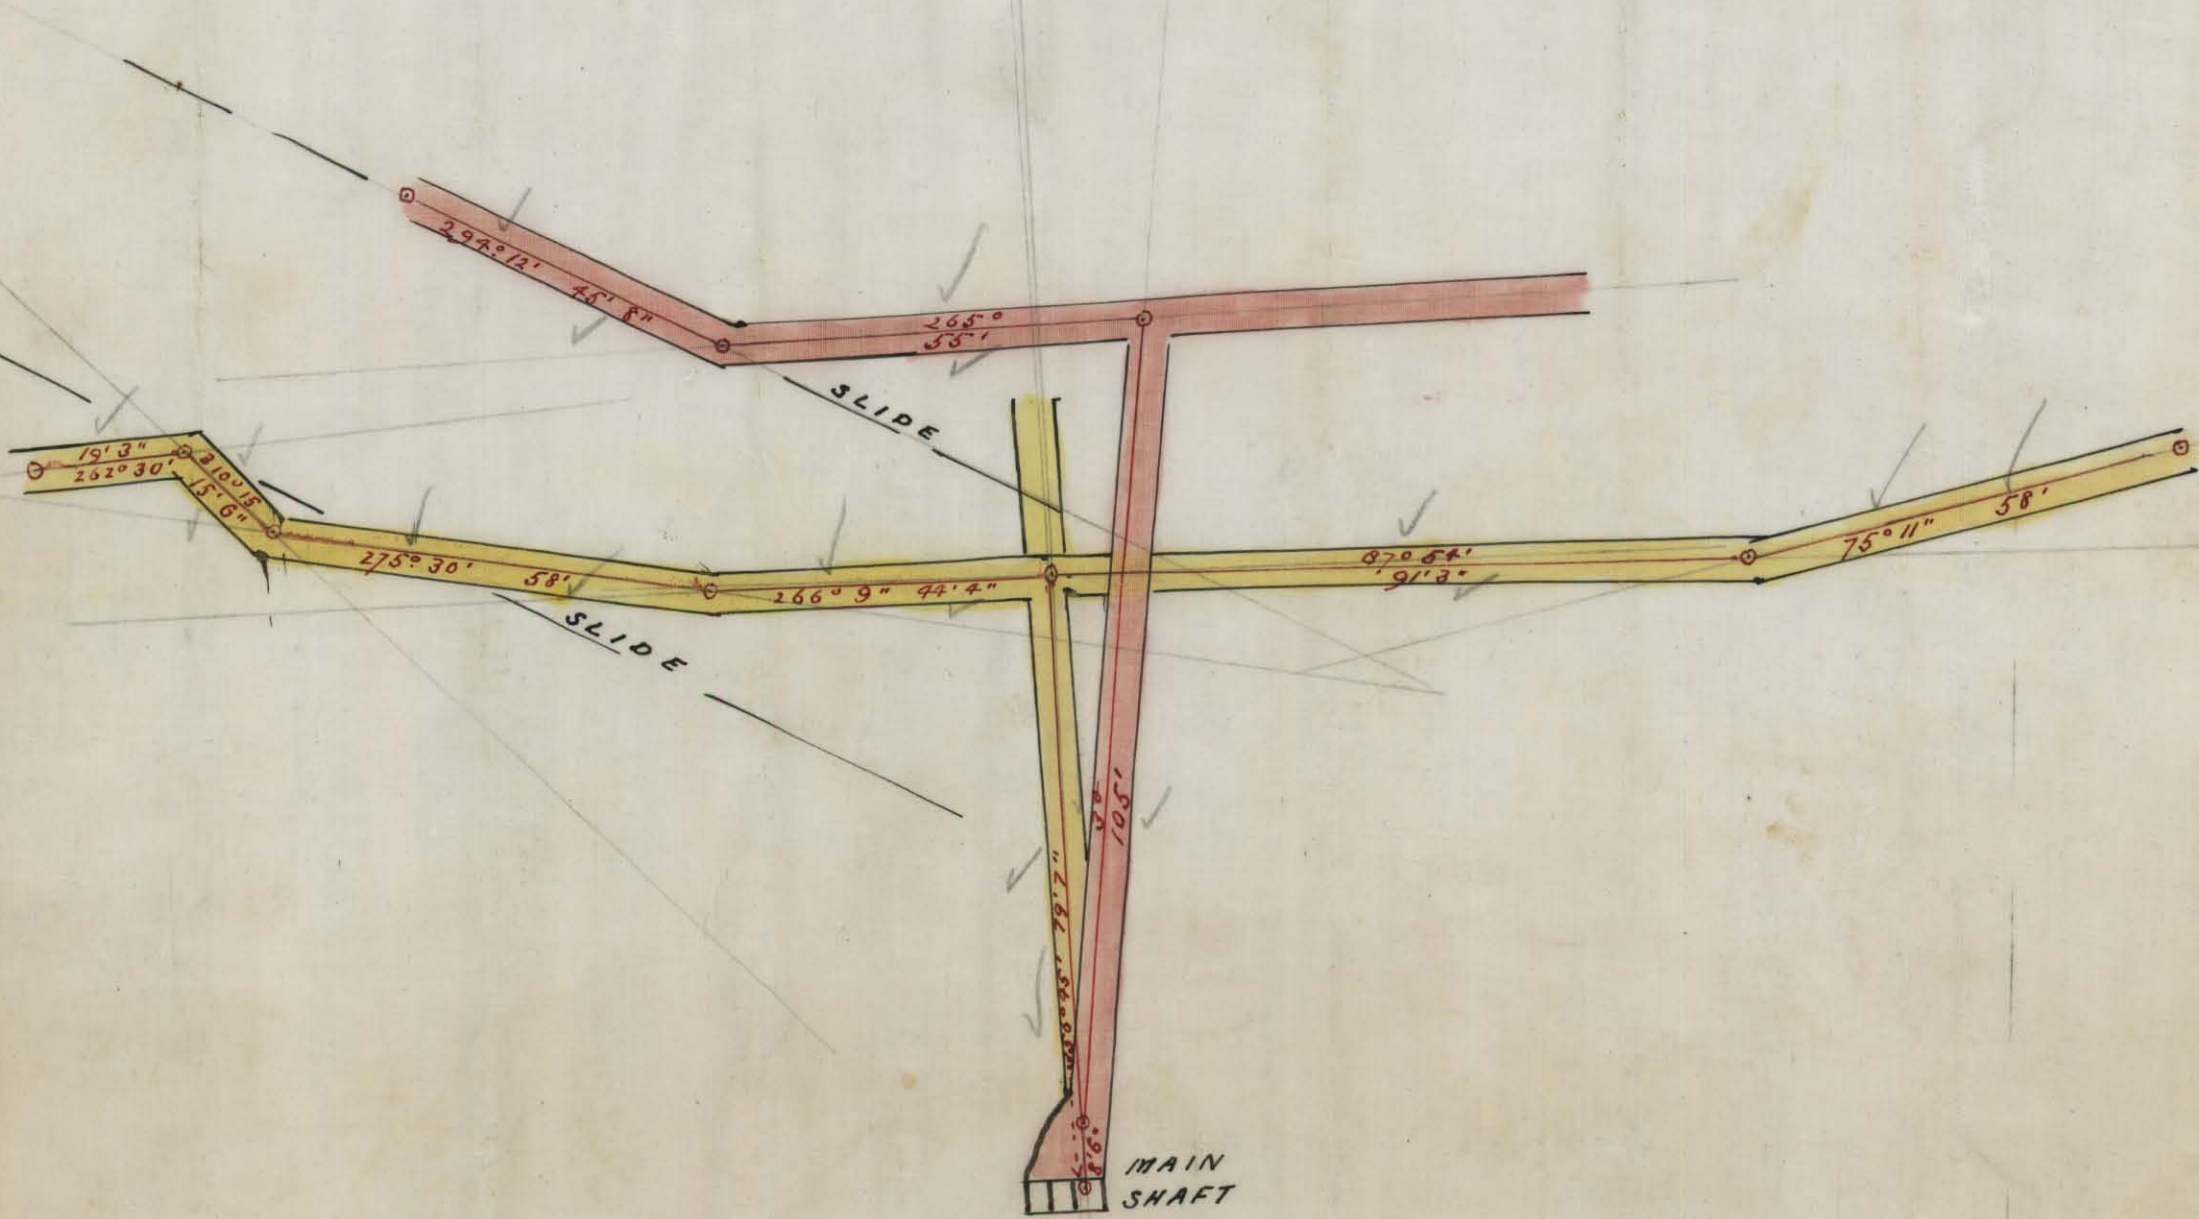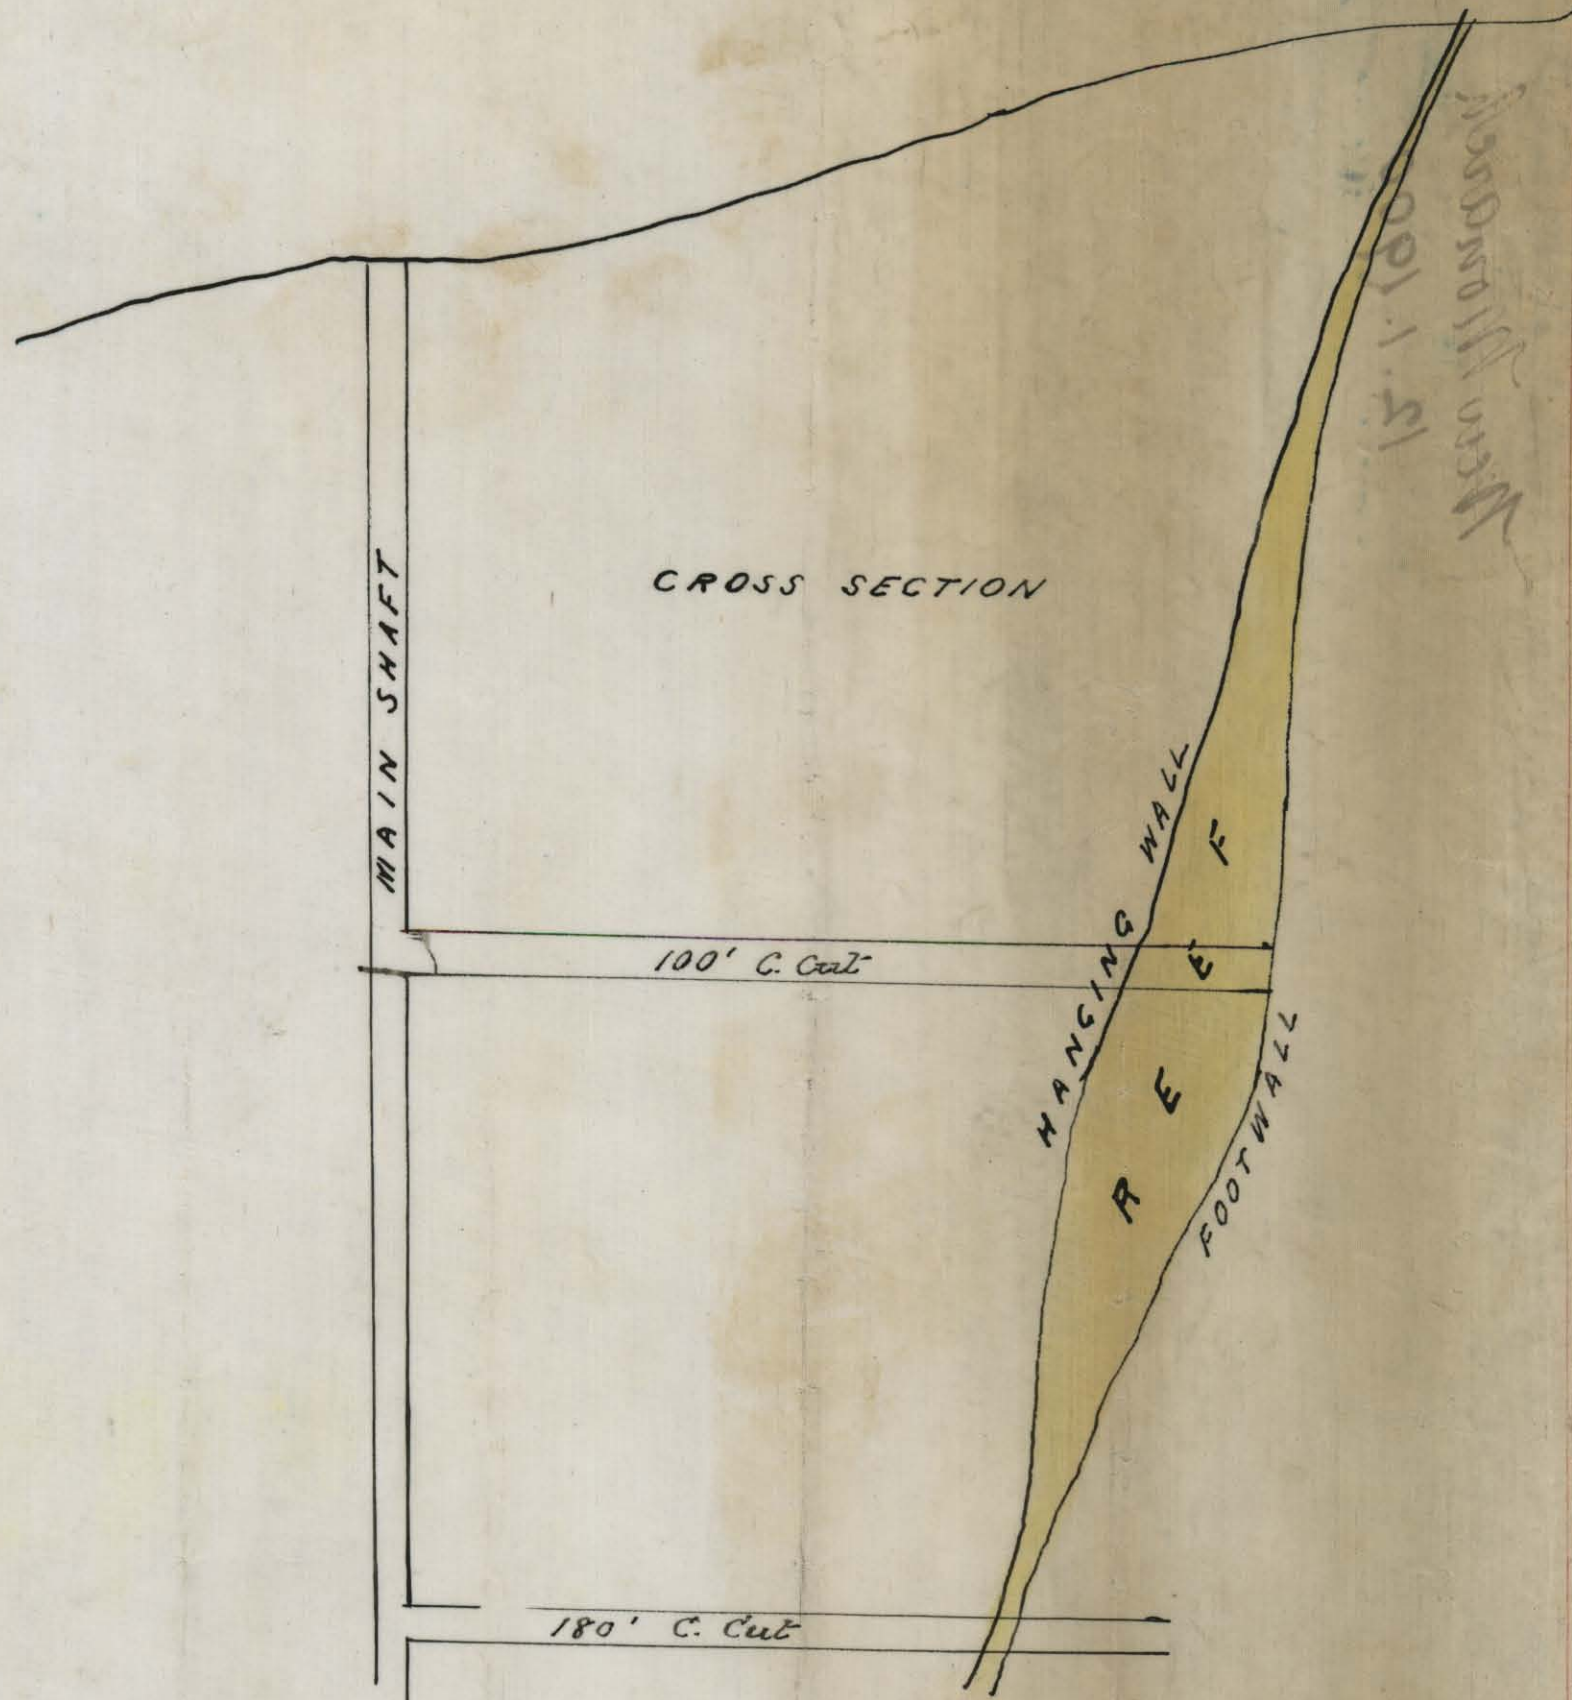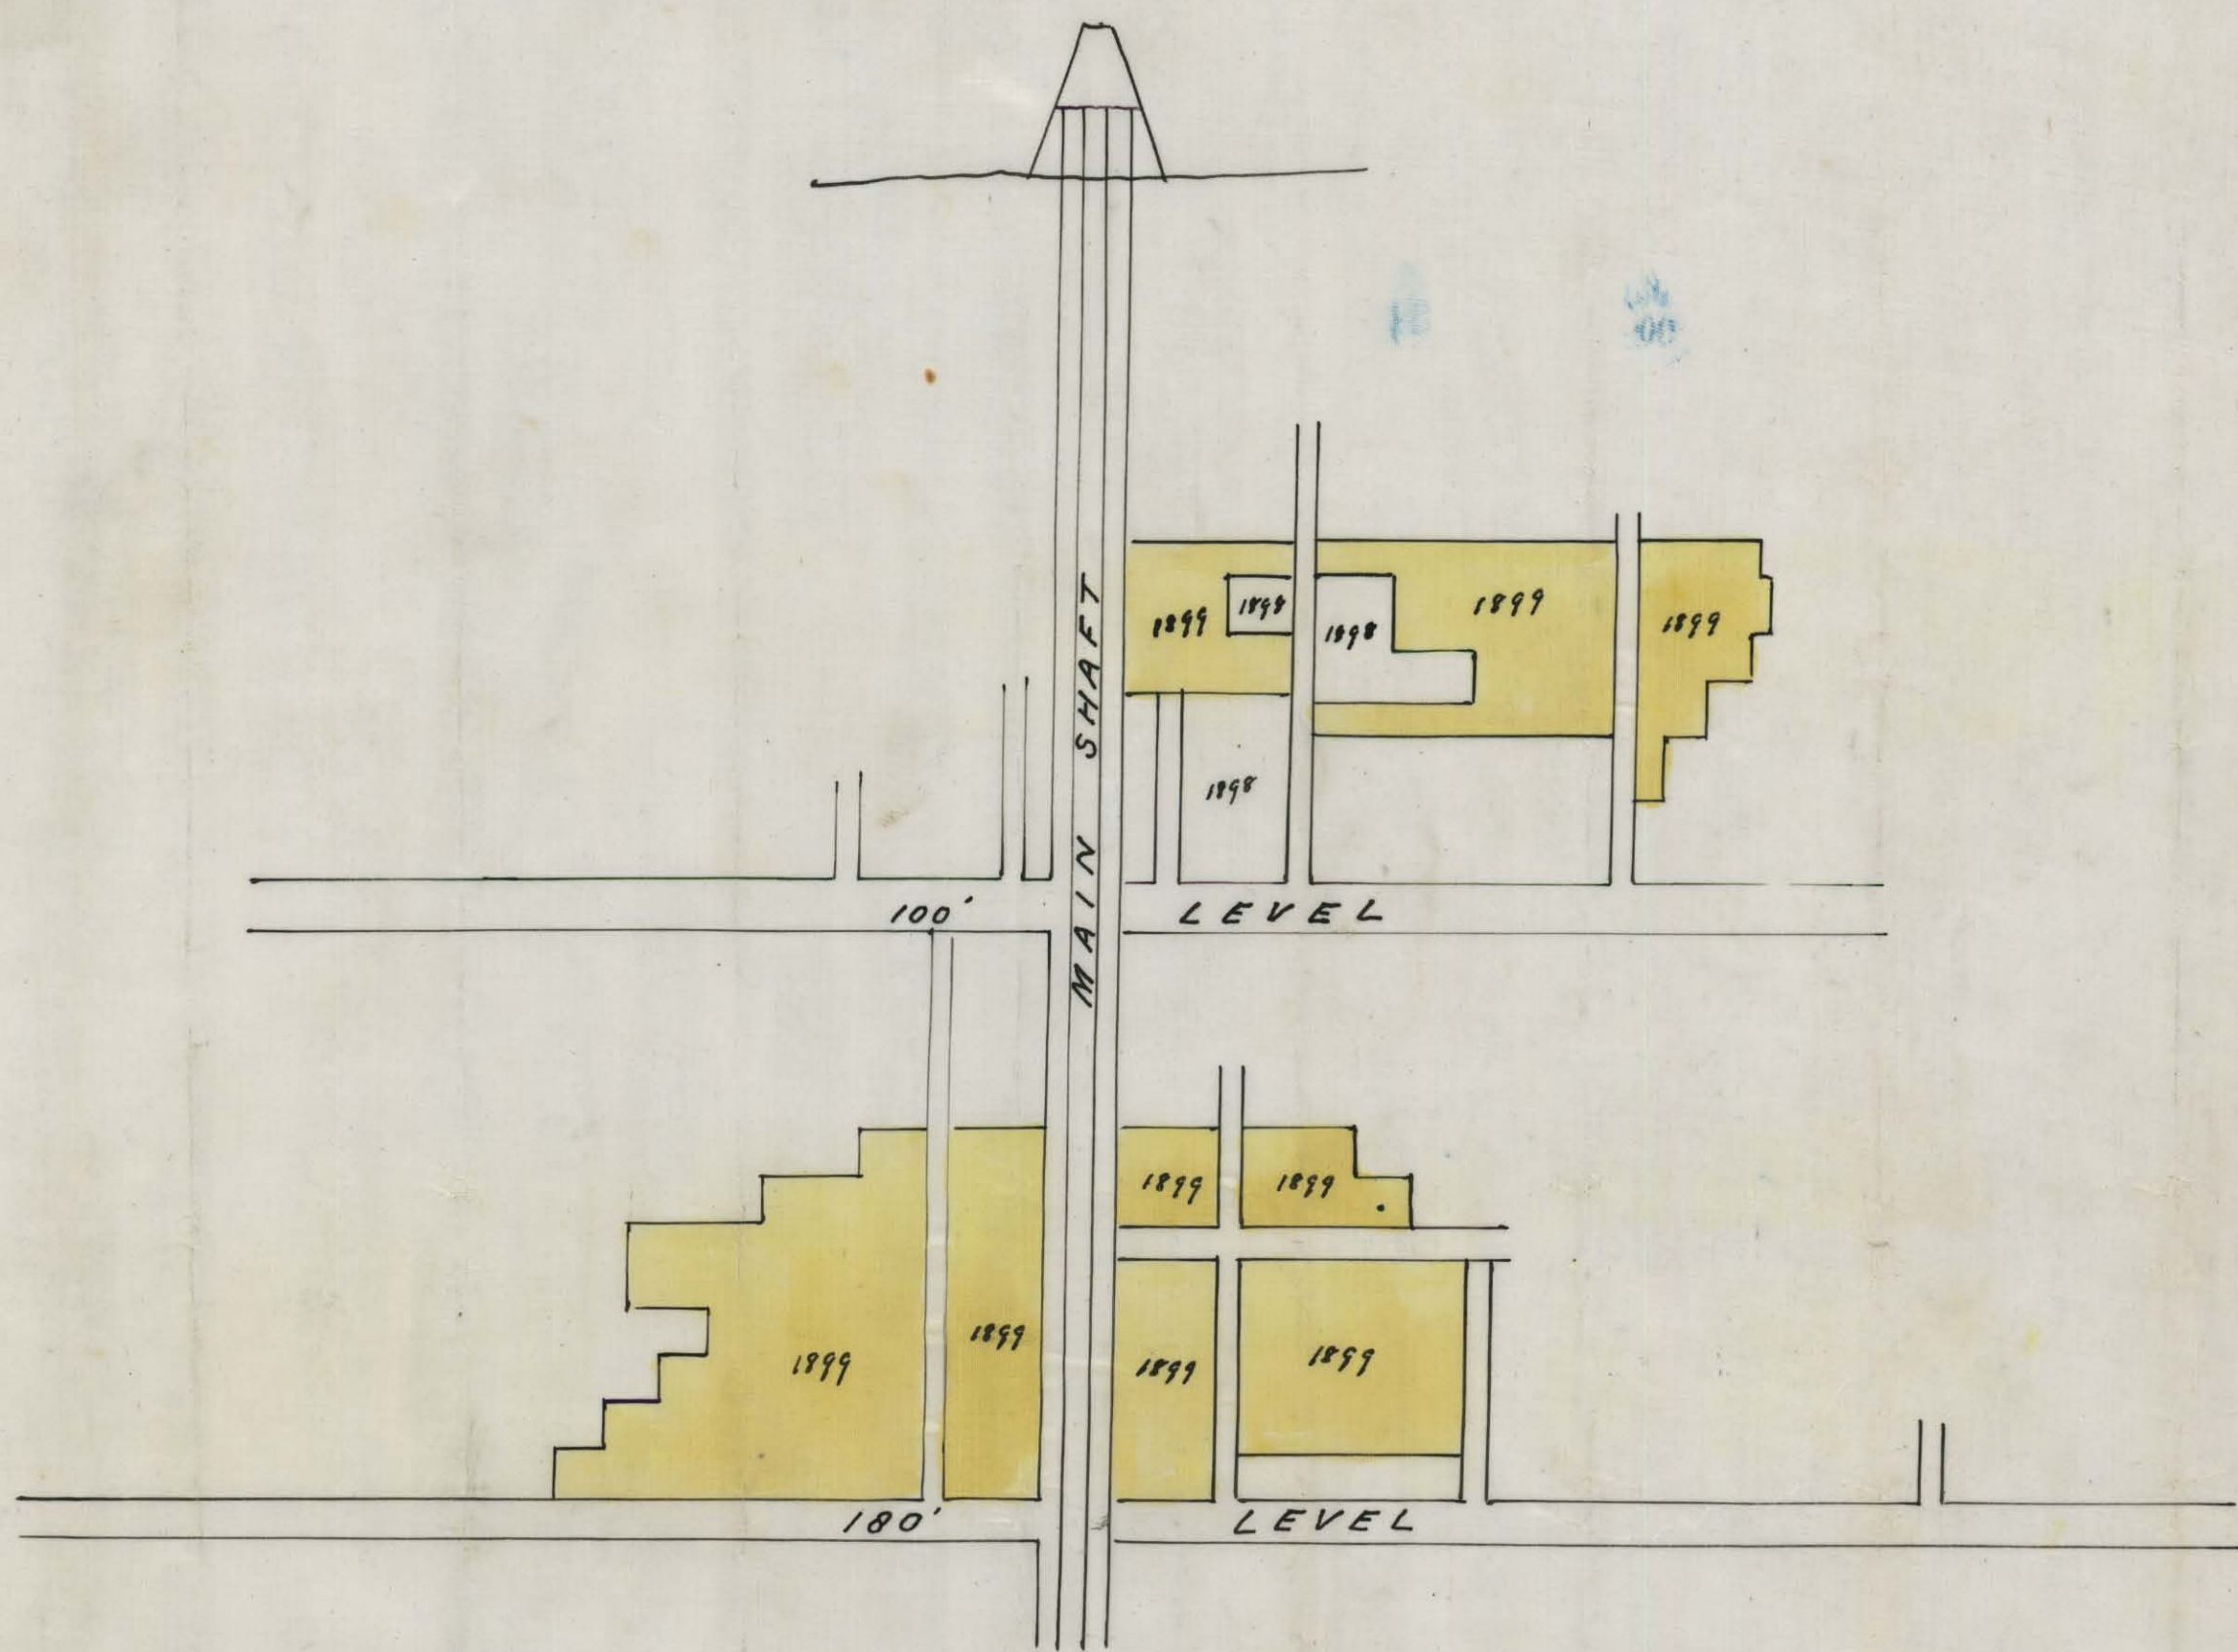

Certified correct
C. Brinley Watson
12/1/1900
Surveyed with theodolite



185

135