
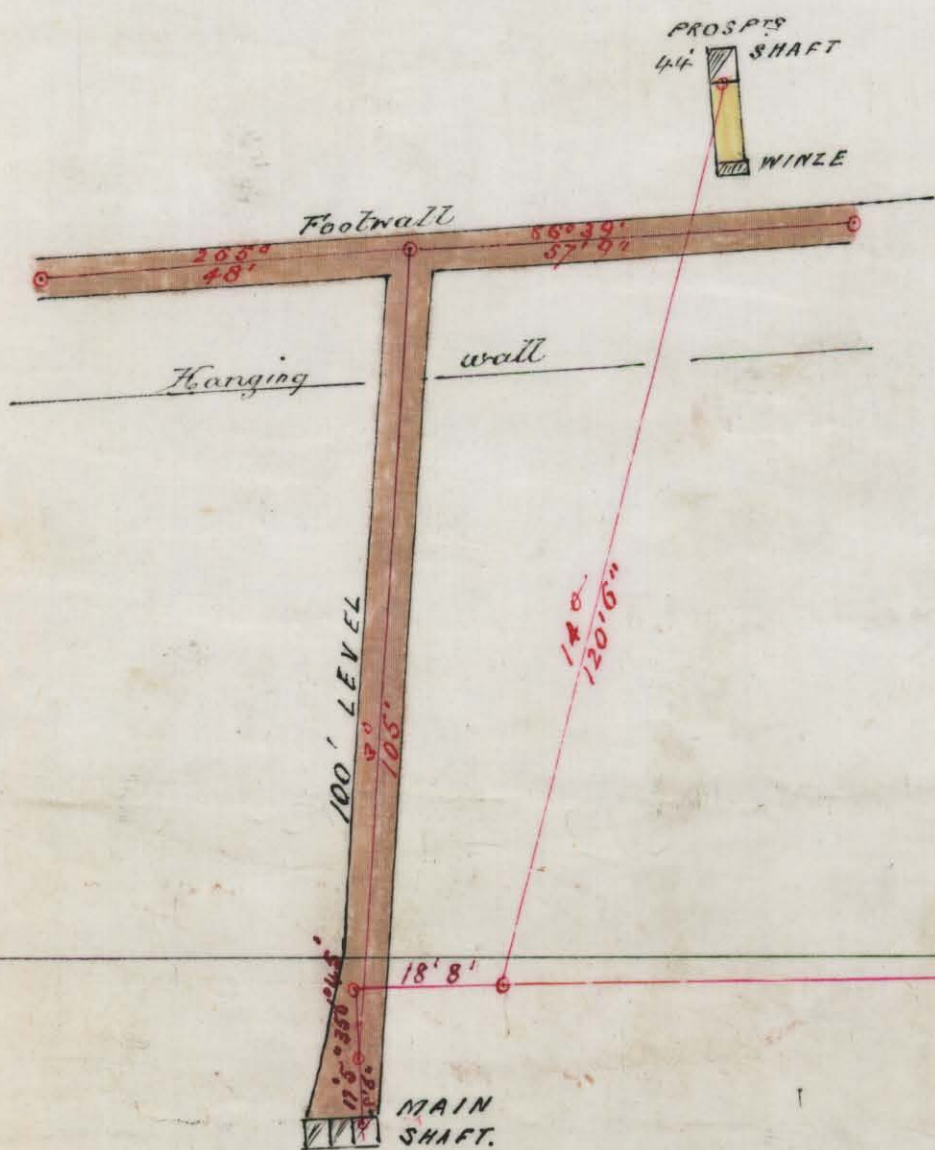
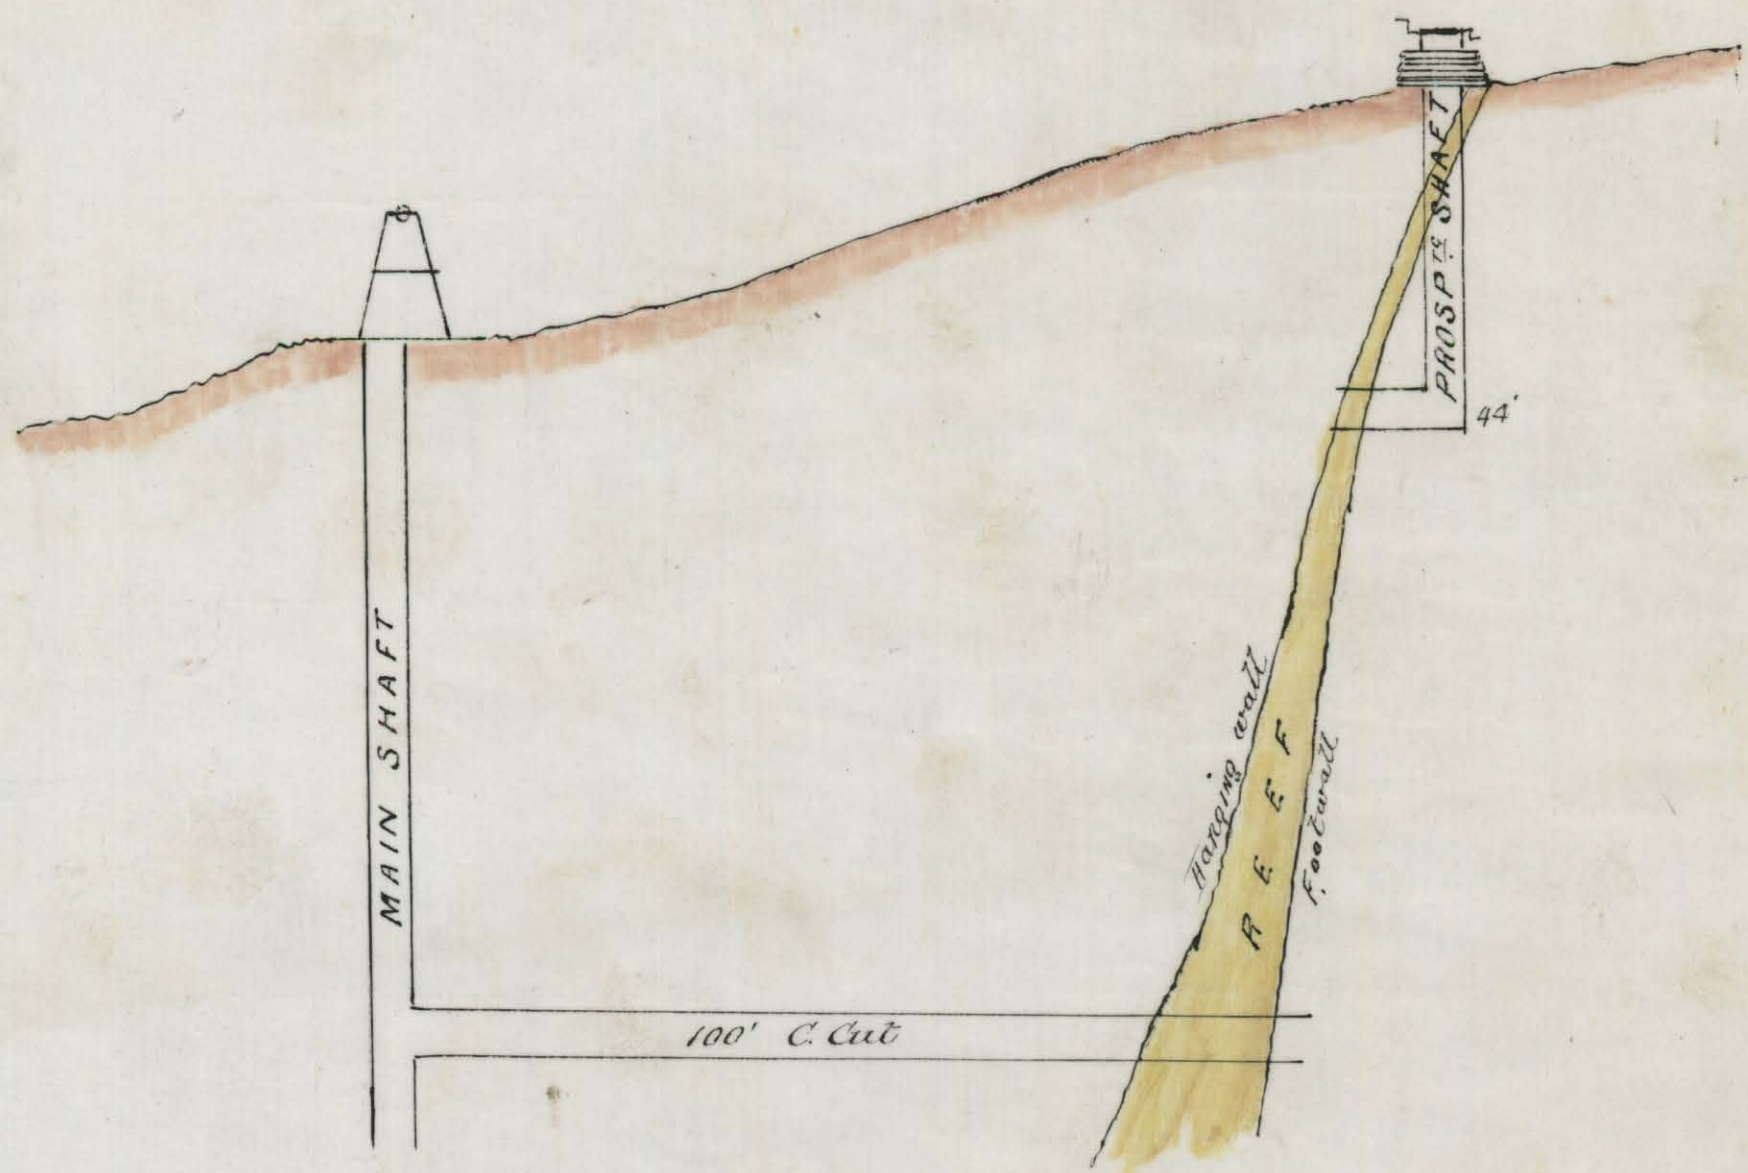


NEW MONARCH G.M.

Scale 25ft. to 1 inch.

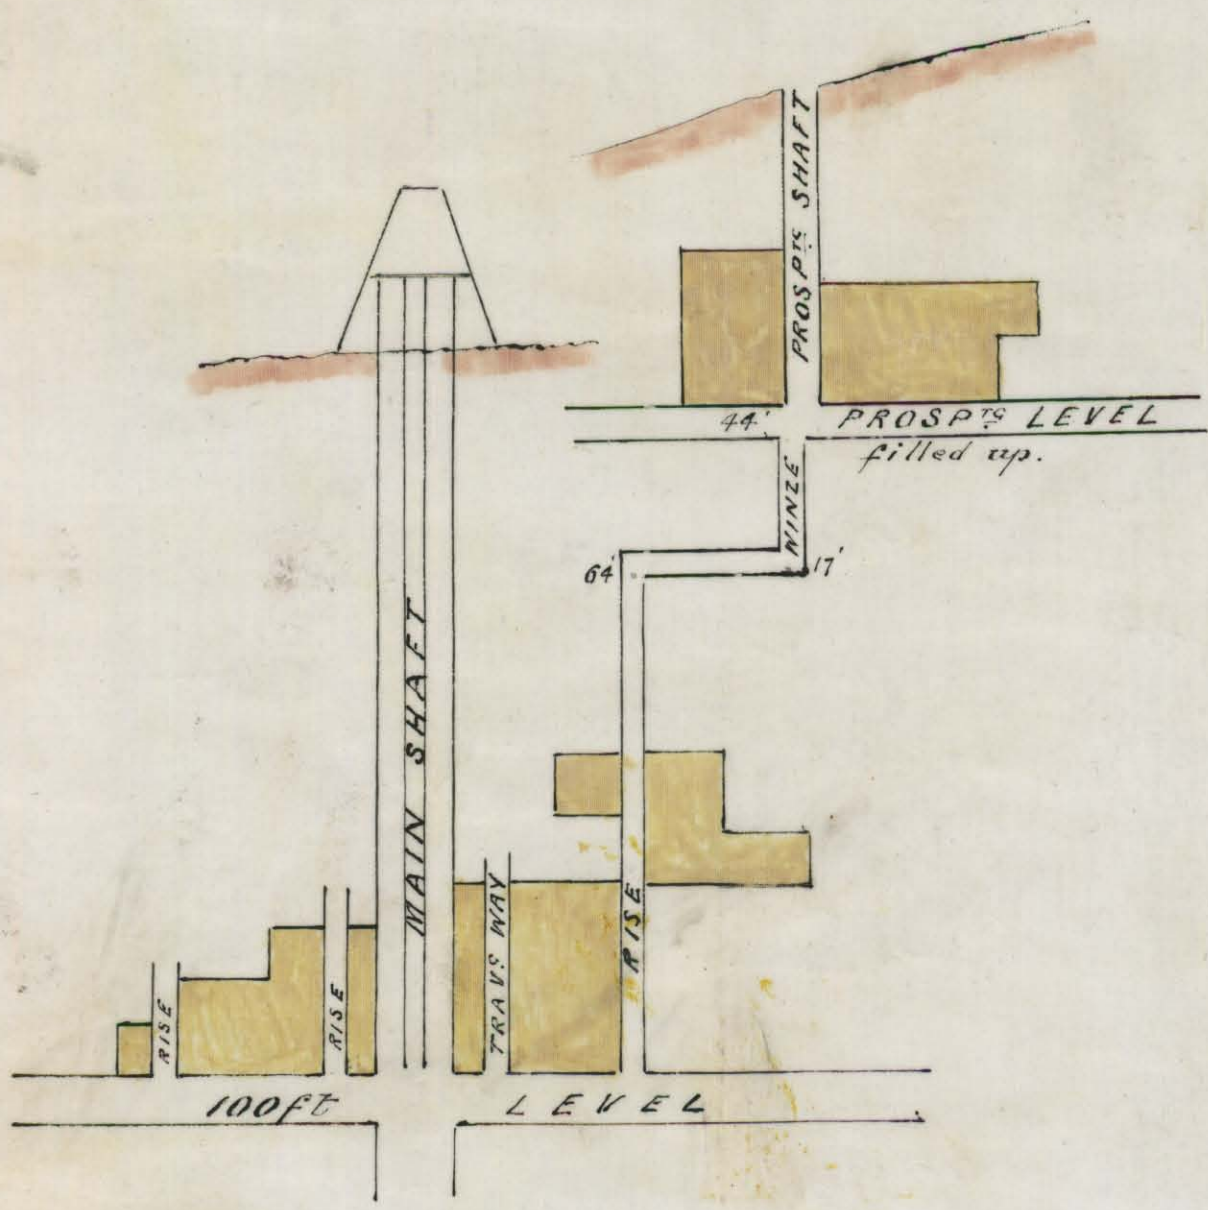

Surveyed with theodolite
C. B. Smith & Co.
20/4/99

1273
934
1274
935
S.E.L.
1266
935

185