



DO NOT SCALE PRINTS. WHEN IN DOUBT, ASK.

REFERENCE DRAWINGS	
DWG. No.	TITLE

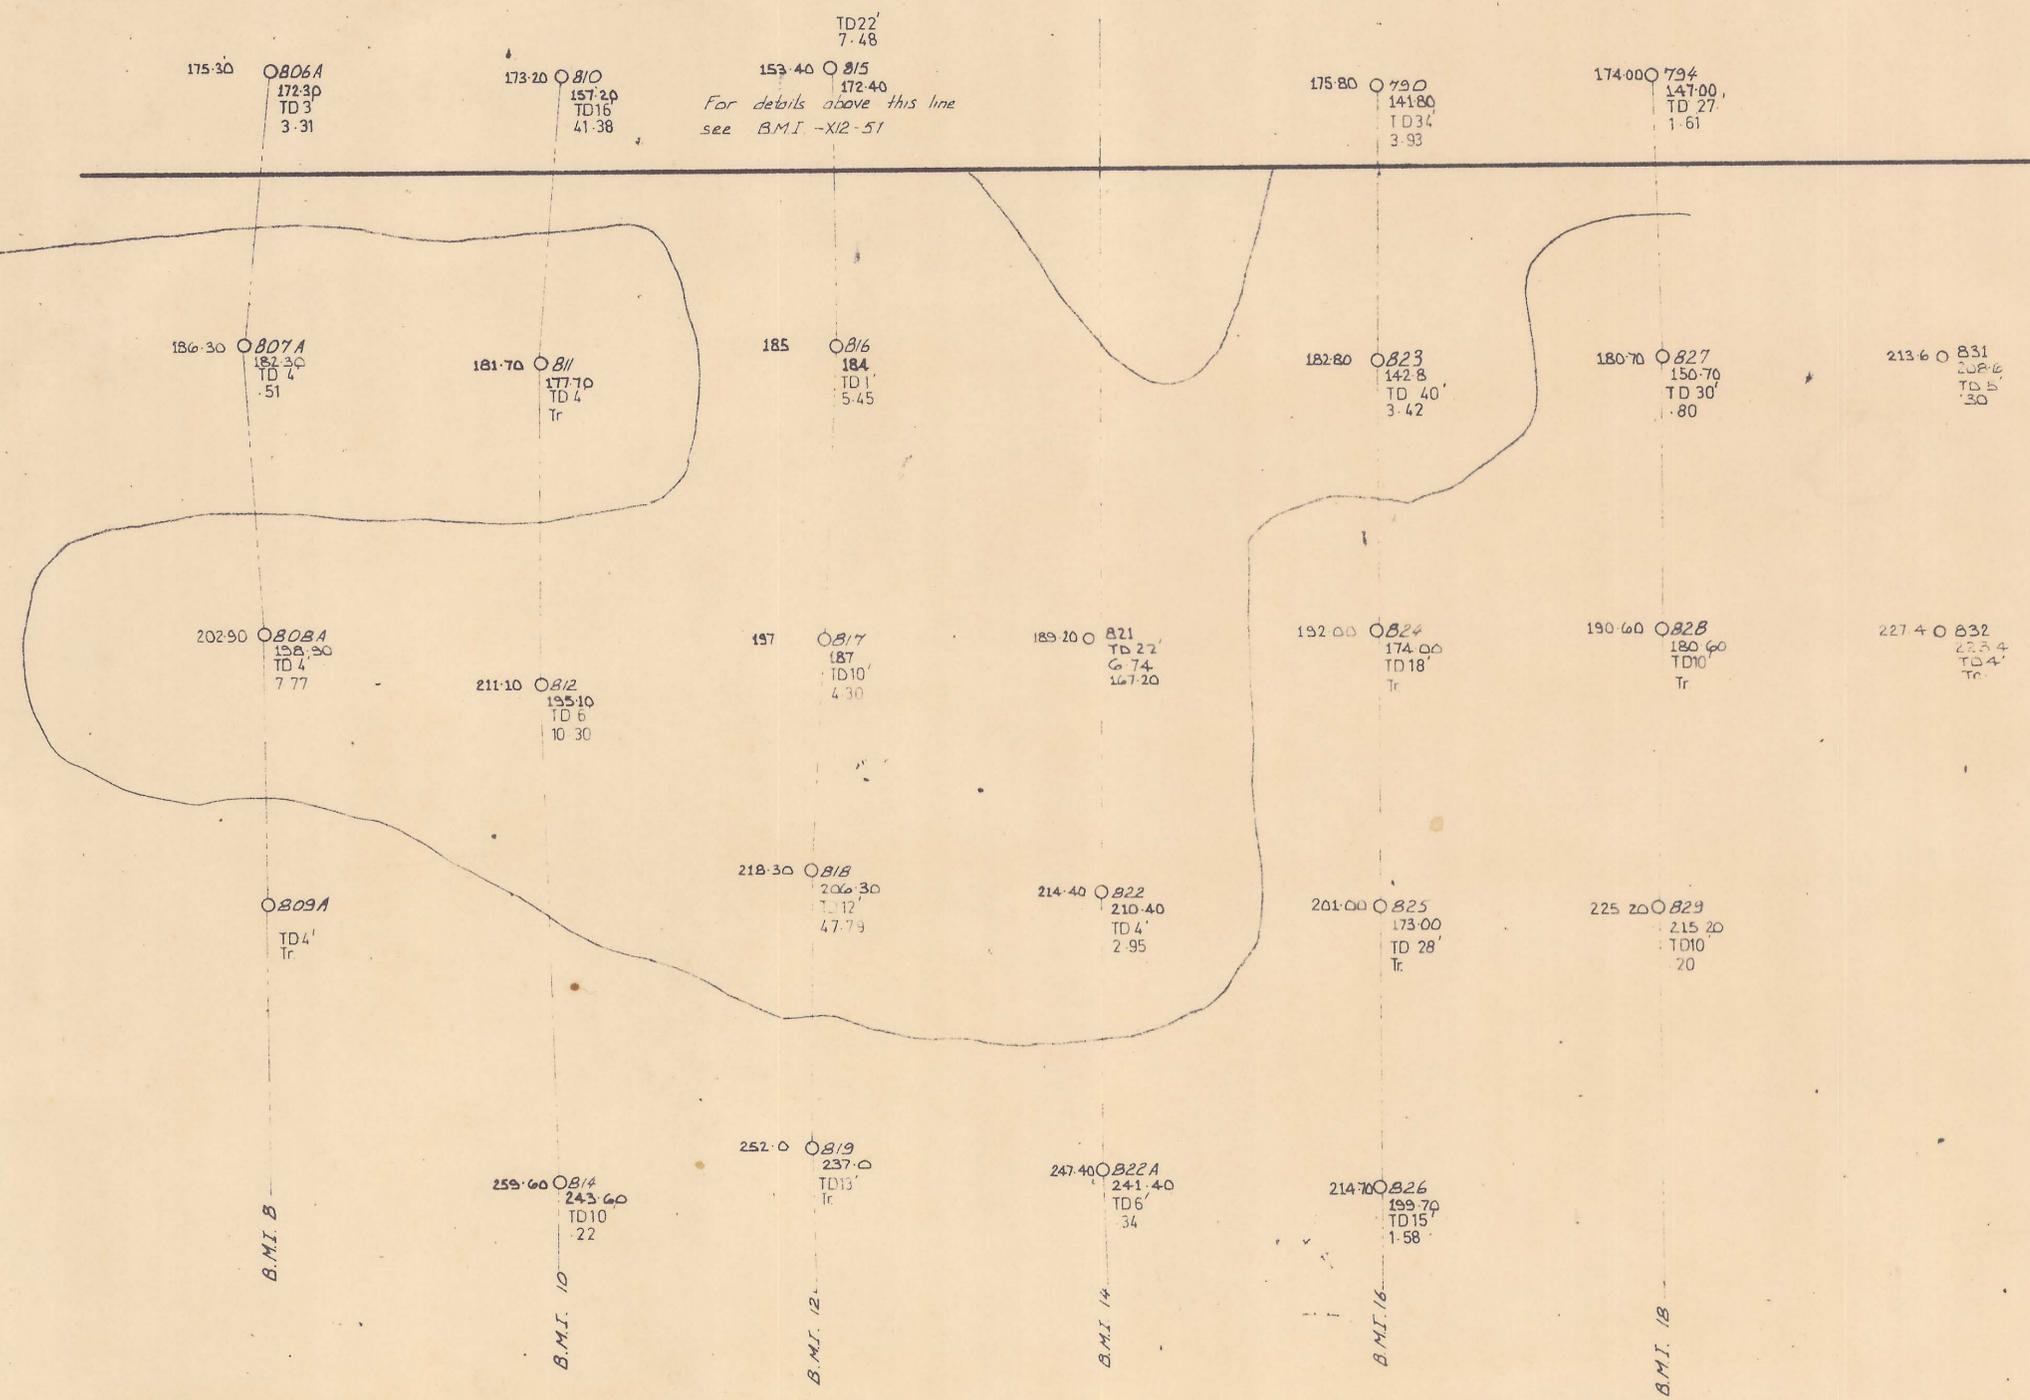

REVISIONS

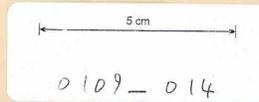

0109-014

B.M.I. MINING PTX. LTD.		Blue Metal Industries Ltd	
MONARCH MINE		SCALE 1"=100'-00"	SIZE
PLAN SHOWING DRILL LINES & ORE BODY		DRAWN R.V. 9-10-74	DRAWING NUMBER
SHEET 2 of 2		CHECKED	B2 BMI-X12-54
		CHIEF DR.	REV.
		APPRD.	

0109-014