


0109_016



PRELIMINARY

0109_016

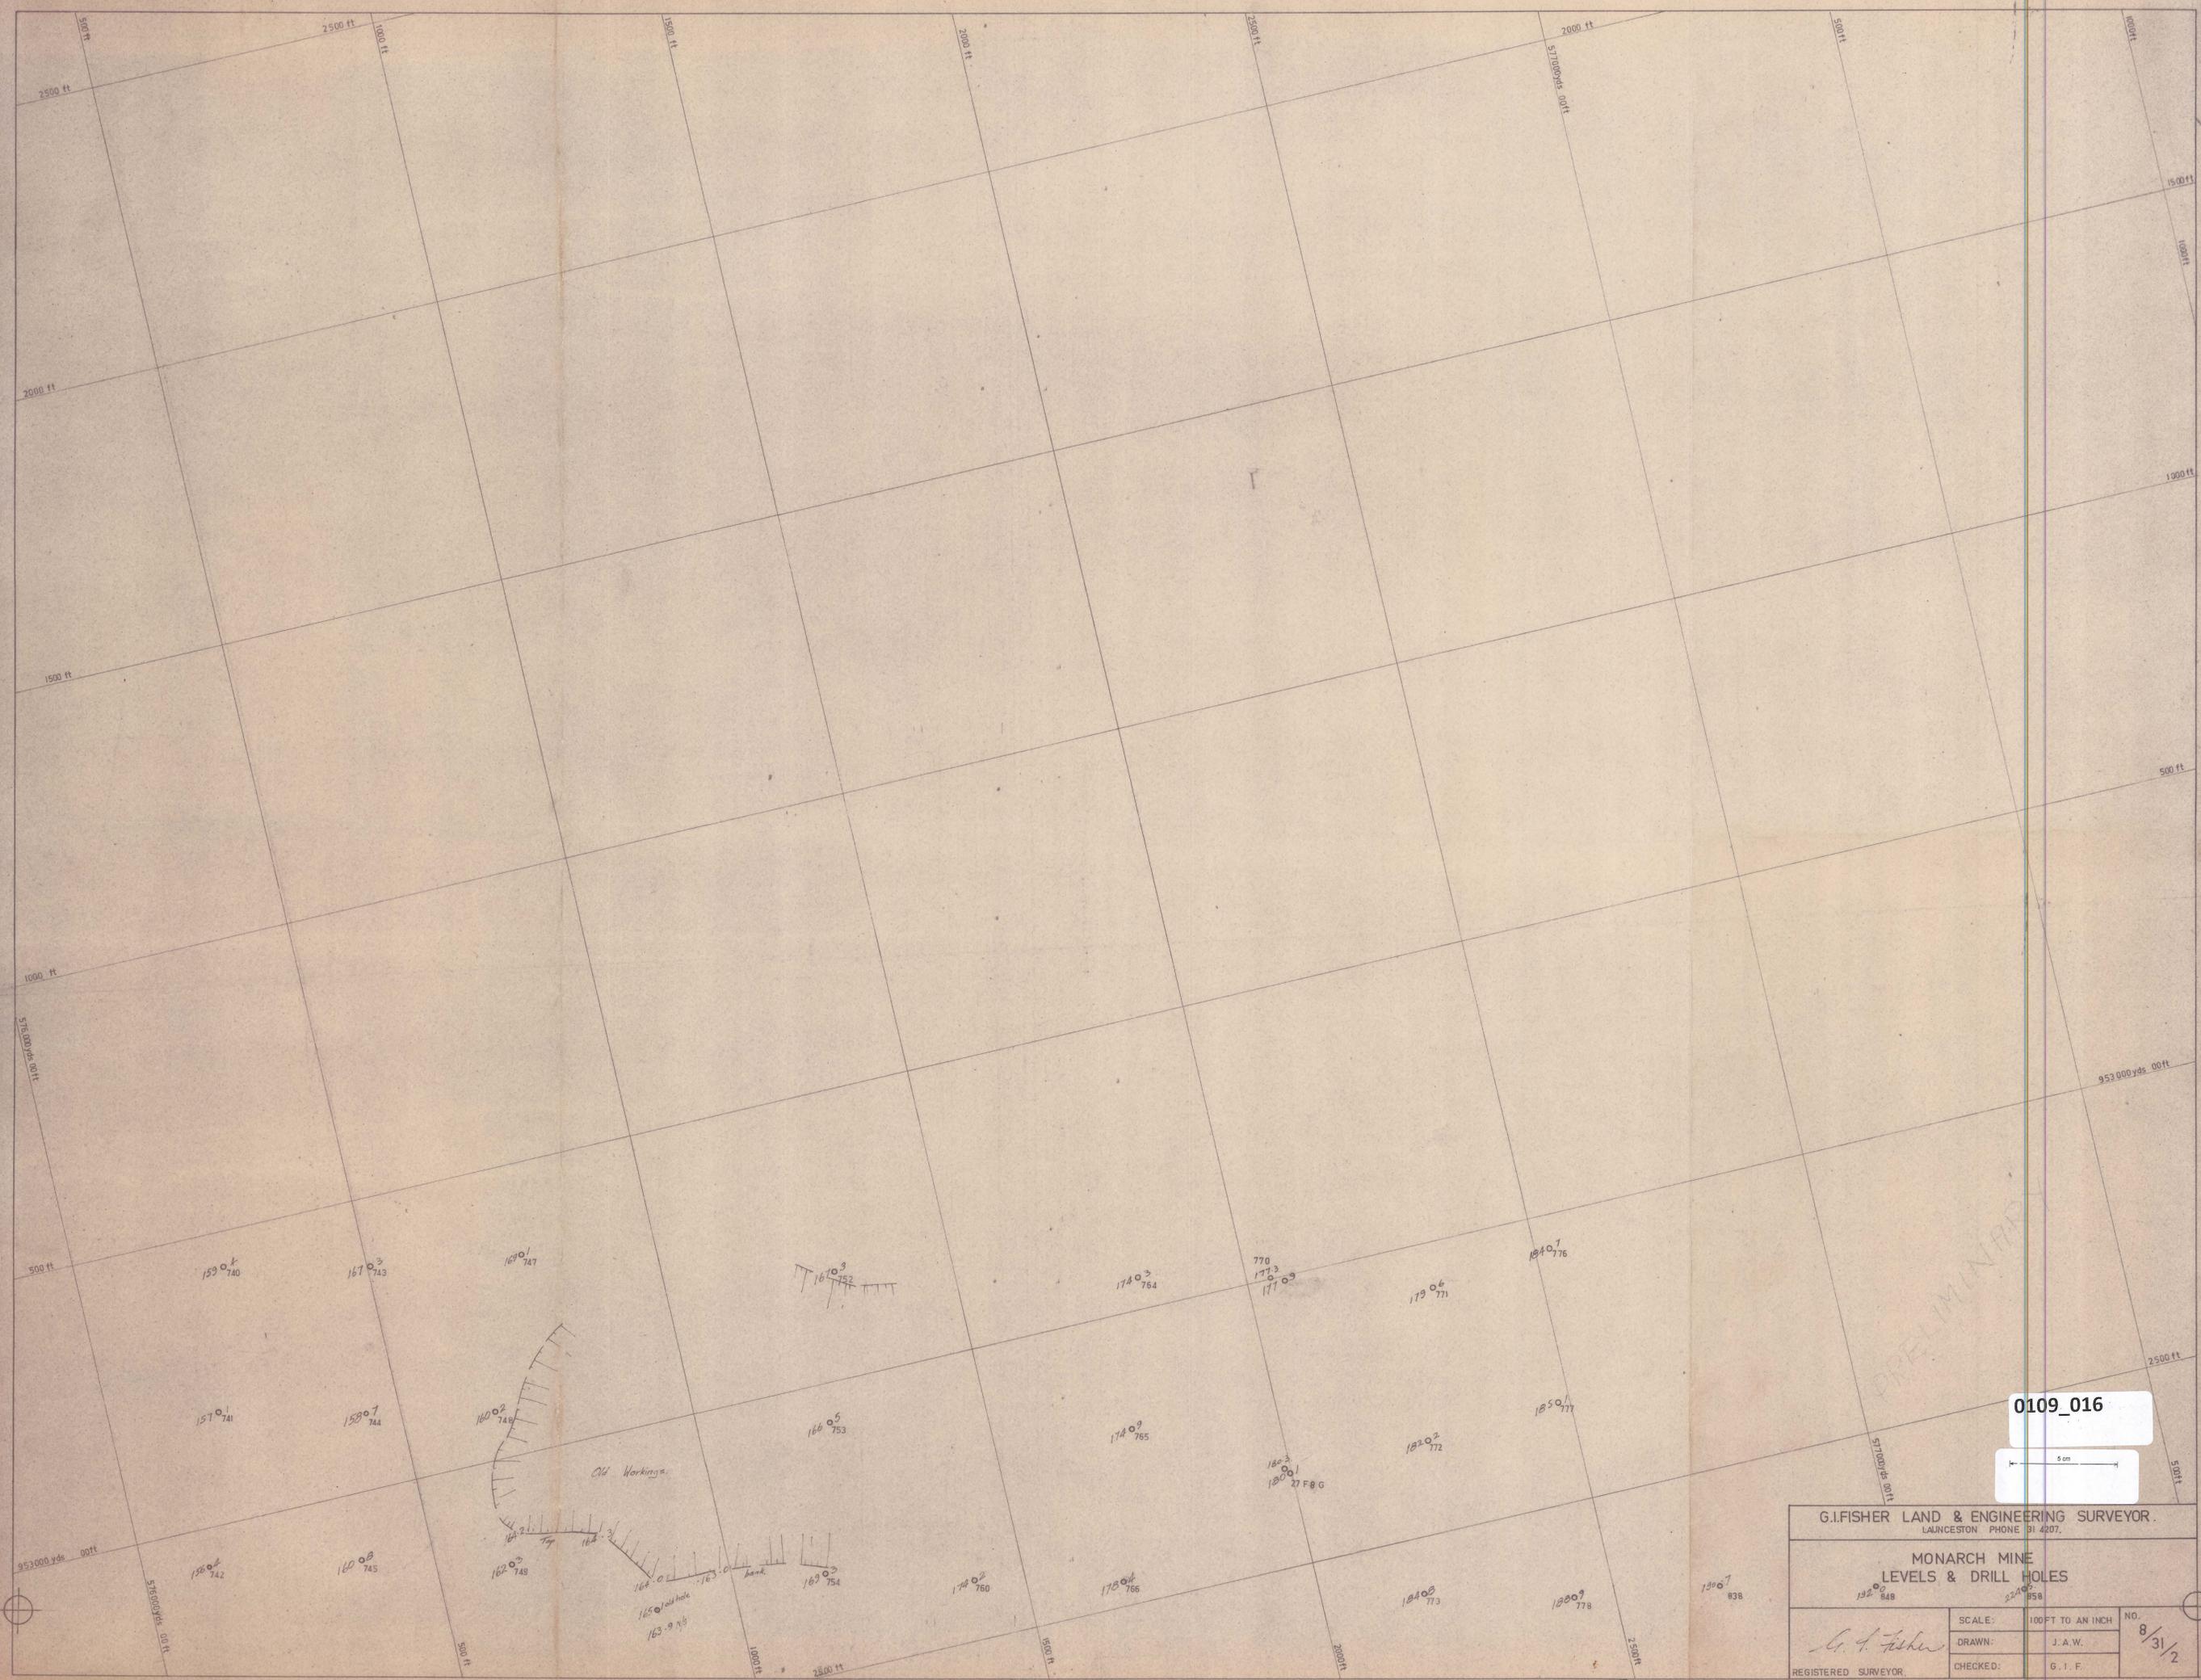

G.I. FISHER LAND & ENGINEERING SURVEYOR.
LAUNCESTON PHONE 31 4207.

**MONARCH MINE
LEVELS & DRILL HOLES**

 REGISTERED SURVEYOR.	SCALE:	100 FT TO AN INCH	NO. 8/31/2
	DRAWN:	J. A. W.	
	CHECKED:	G. I. F.	