

+ PM 1
0183.43 N
0818.92 E

Hole No.	Depth	Remarks
1	3.67	
2	4.74	
3	10.97	
4	11.00	
5	12.71	
6	11.29	
7	11.54	
8	8.57	
9	10.83	
10	12.02	
11	15.85	
12	7.22	
13	3.25	
14	2.41	
15	10.67	
16	6.14	
17	None	
18	9.13	
19	10.92	
20	2.20	
21	17.54	
22	12.79	
23	55.08	
24	8.84	
25	17.23	
26	20.97	
27	21.88	
28	36.69	
29	9.80	
30	27.28	
31	107.42	
32	88.77	
33	127.47	
34	60.28	
35		

953 000 yds N

2500 ft N

575 000 yds
952 000 yds 2000 ft N

500 ft E

575 000 yds
1000 ft E


B.M.I. MINING PTY. LTD.

MONARCH MINE WORKING PLAN

SCALE: 50 FEET TO AN INCH



0109_034

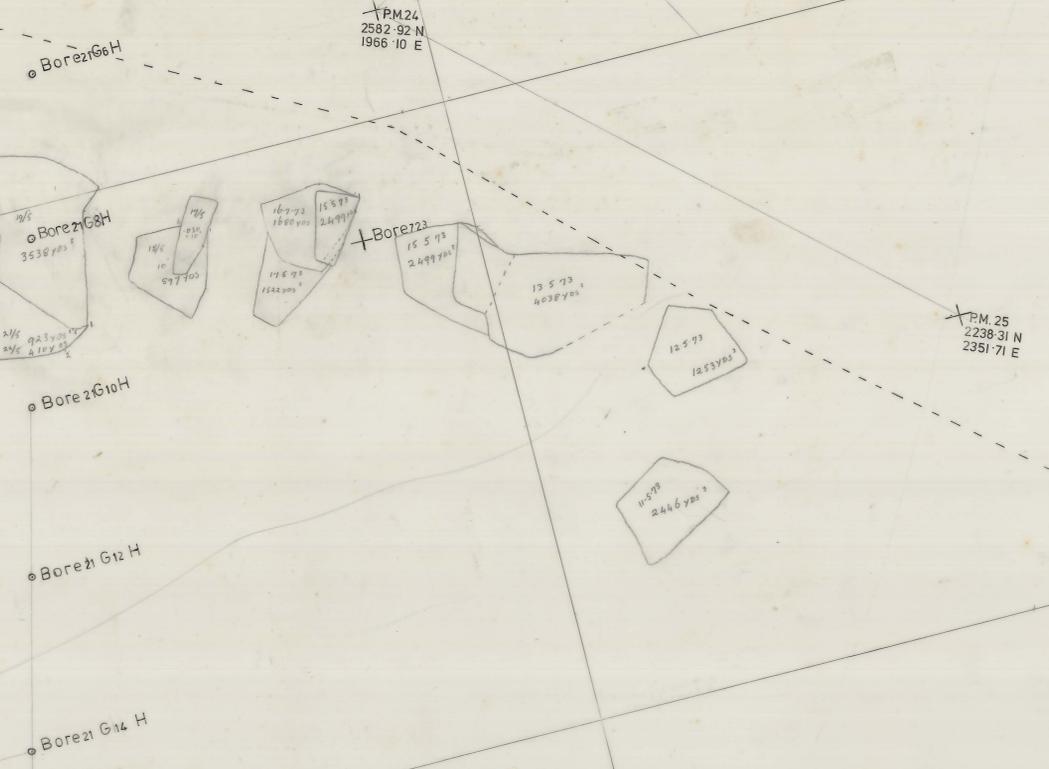

575 000 yds E

2000 ft E
952 000 yds 1500 ft N

2500 ft E