


PLAN
OF
NEW LONDON AND TASMANIAN G.M.Co. N.L.
SPECIMEN REEF,
TASMANIA
N° 3 TUNNEL
Scale 25 feet to 1 inch

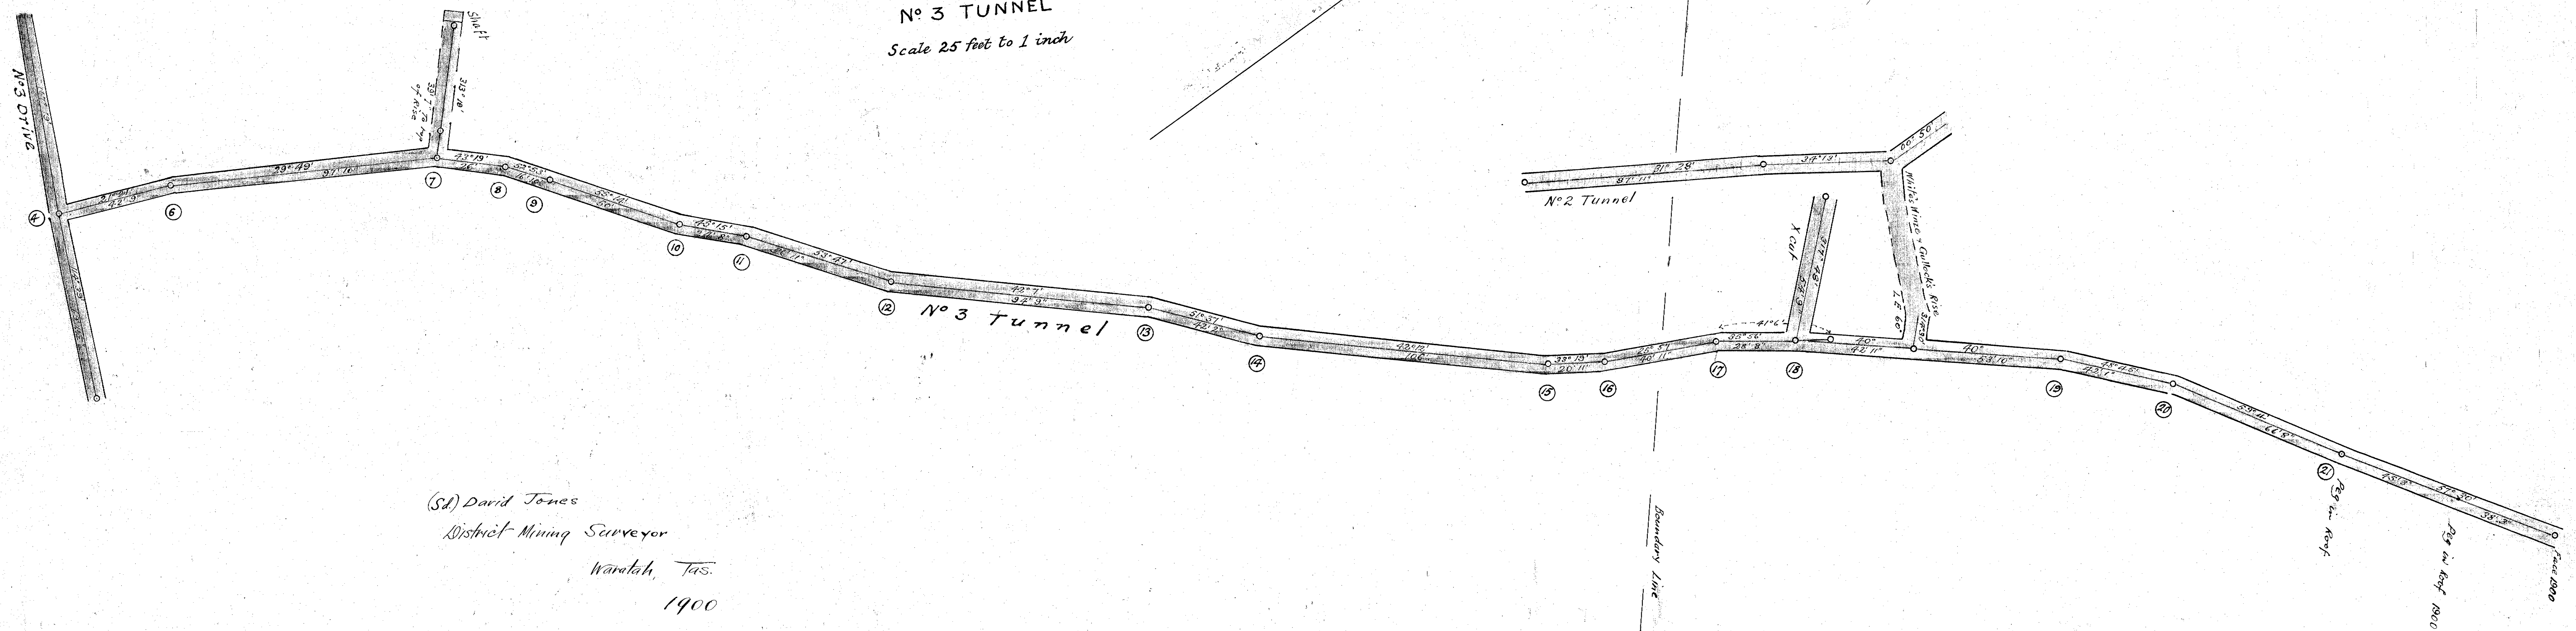

(Sd.) David Jones
District Mining Surveyor
Wardah, Tas.
1900

110-02
110-02

110-02