
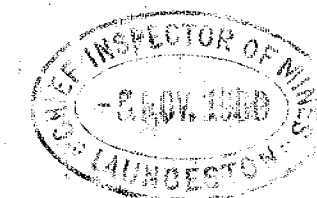


PLAN
OF
NEW LONDON AND TASMANIAN G.M.C., N.L.
SPECIMEN REEF,
TASMANIA.

Nº 3 TUNNEL.
Scale 25 feet to 1 inch.

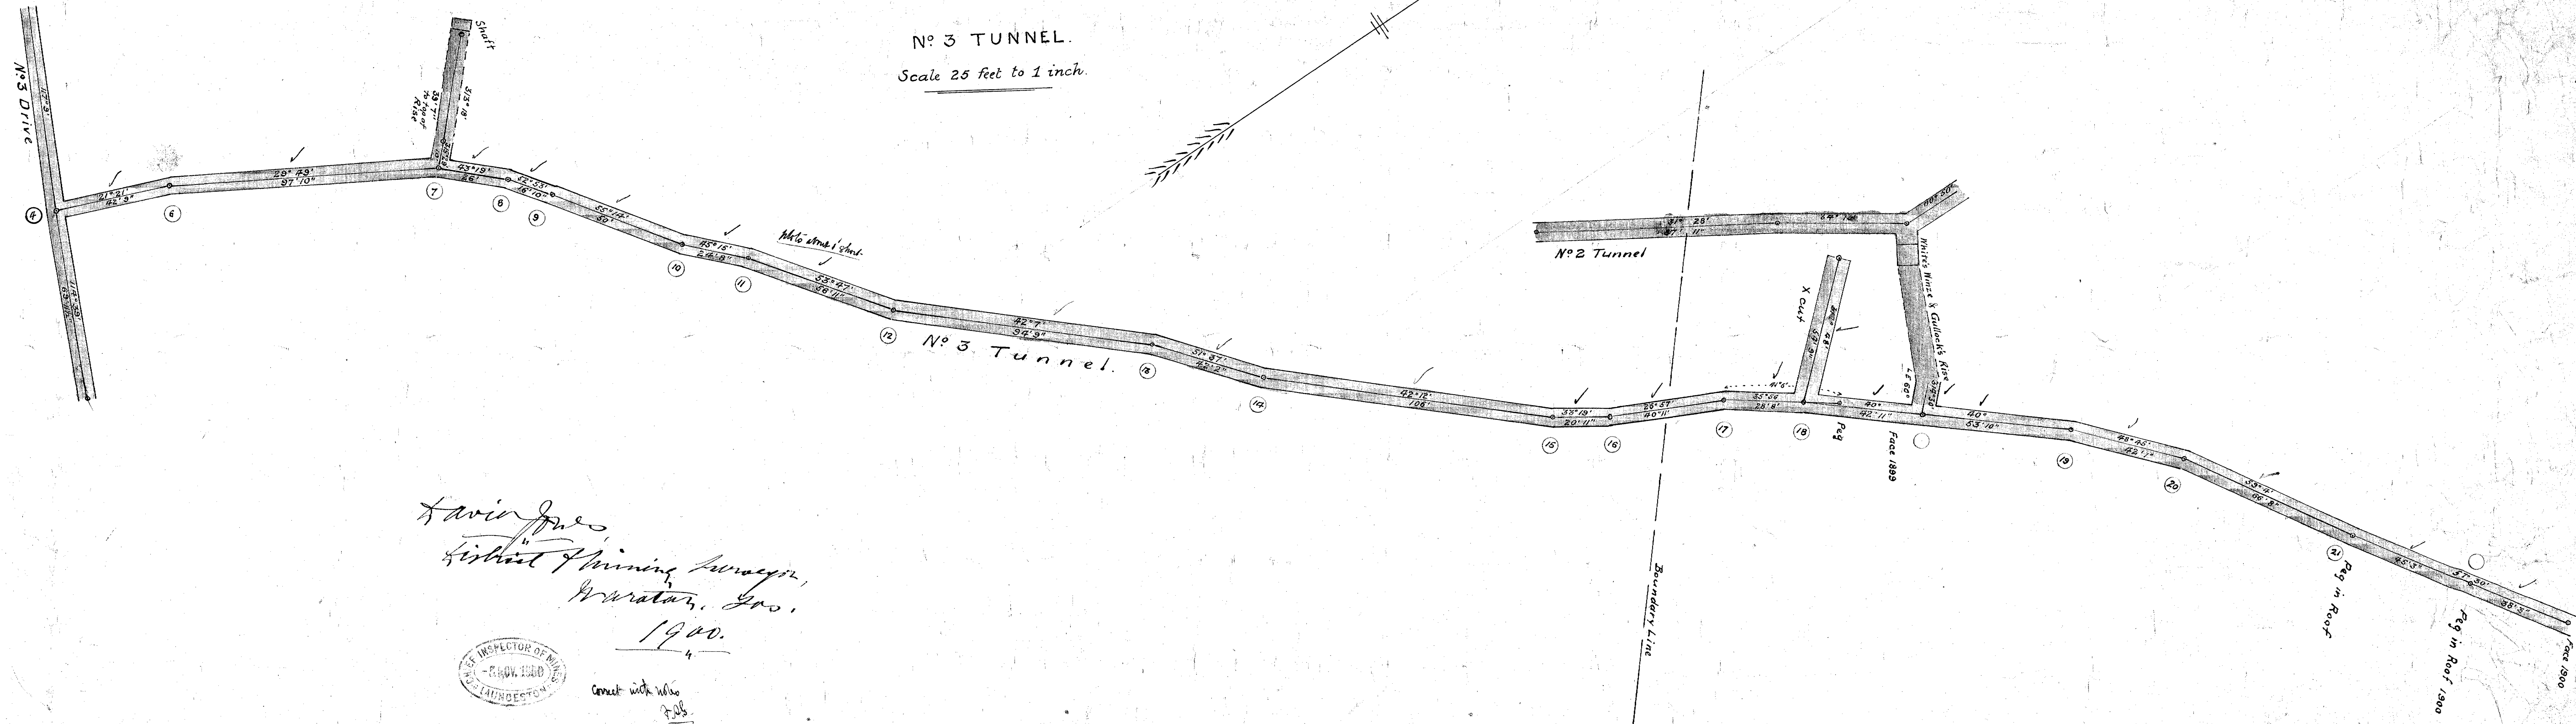

Correct with N.L.S.
Feb.

David Jones
District Mining Surveyor,
Hobart, Tas.
1900.

5 cm

30-011

30-011