


III-01

5 cm

BRANDY CREEK C.M.

Scale 33 ft. to an inch

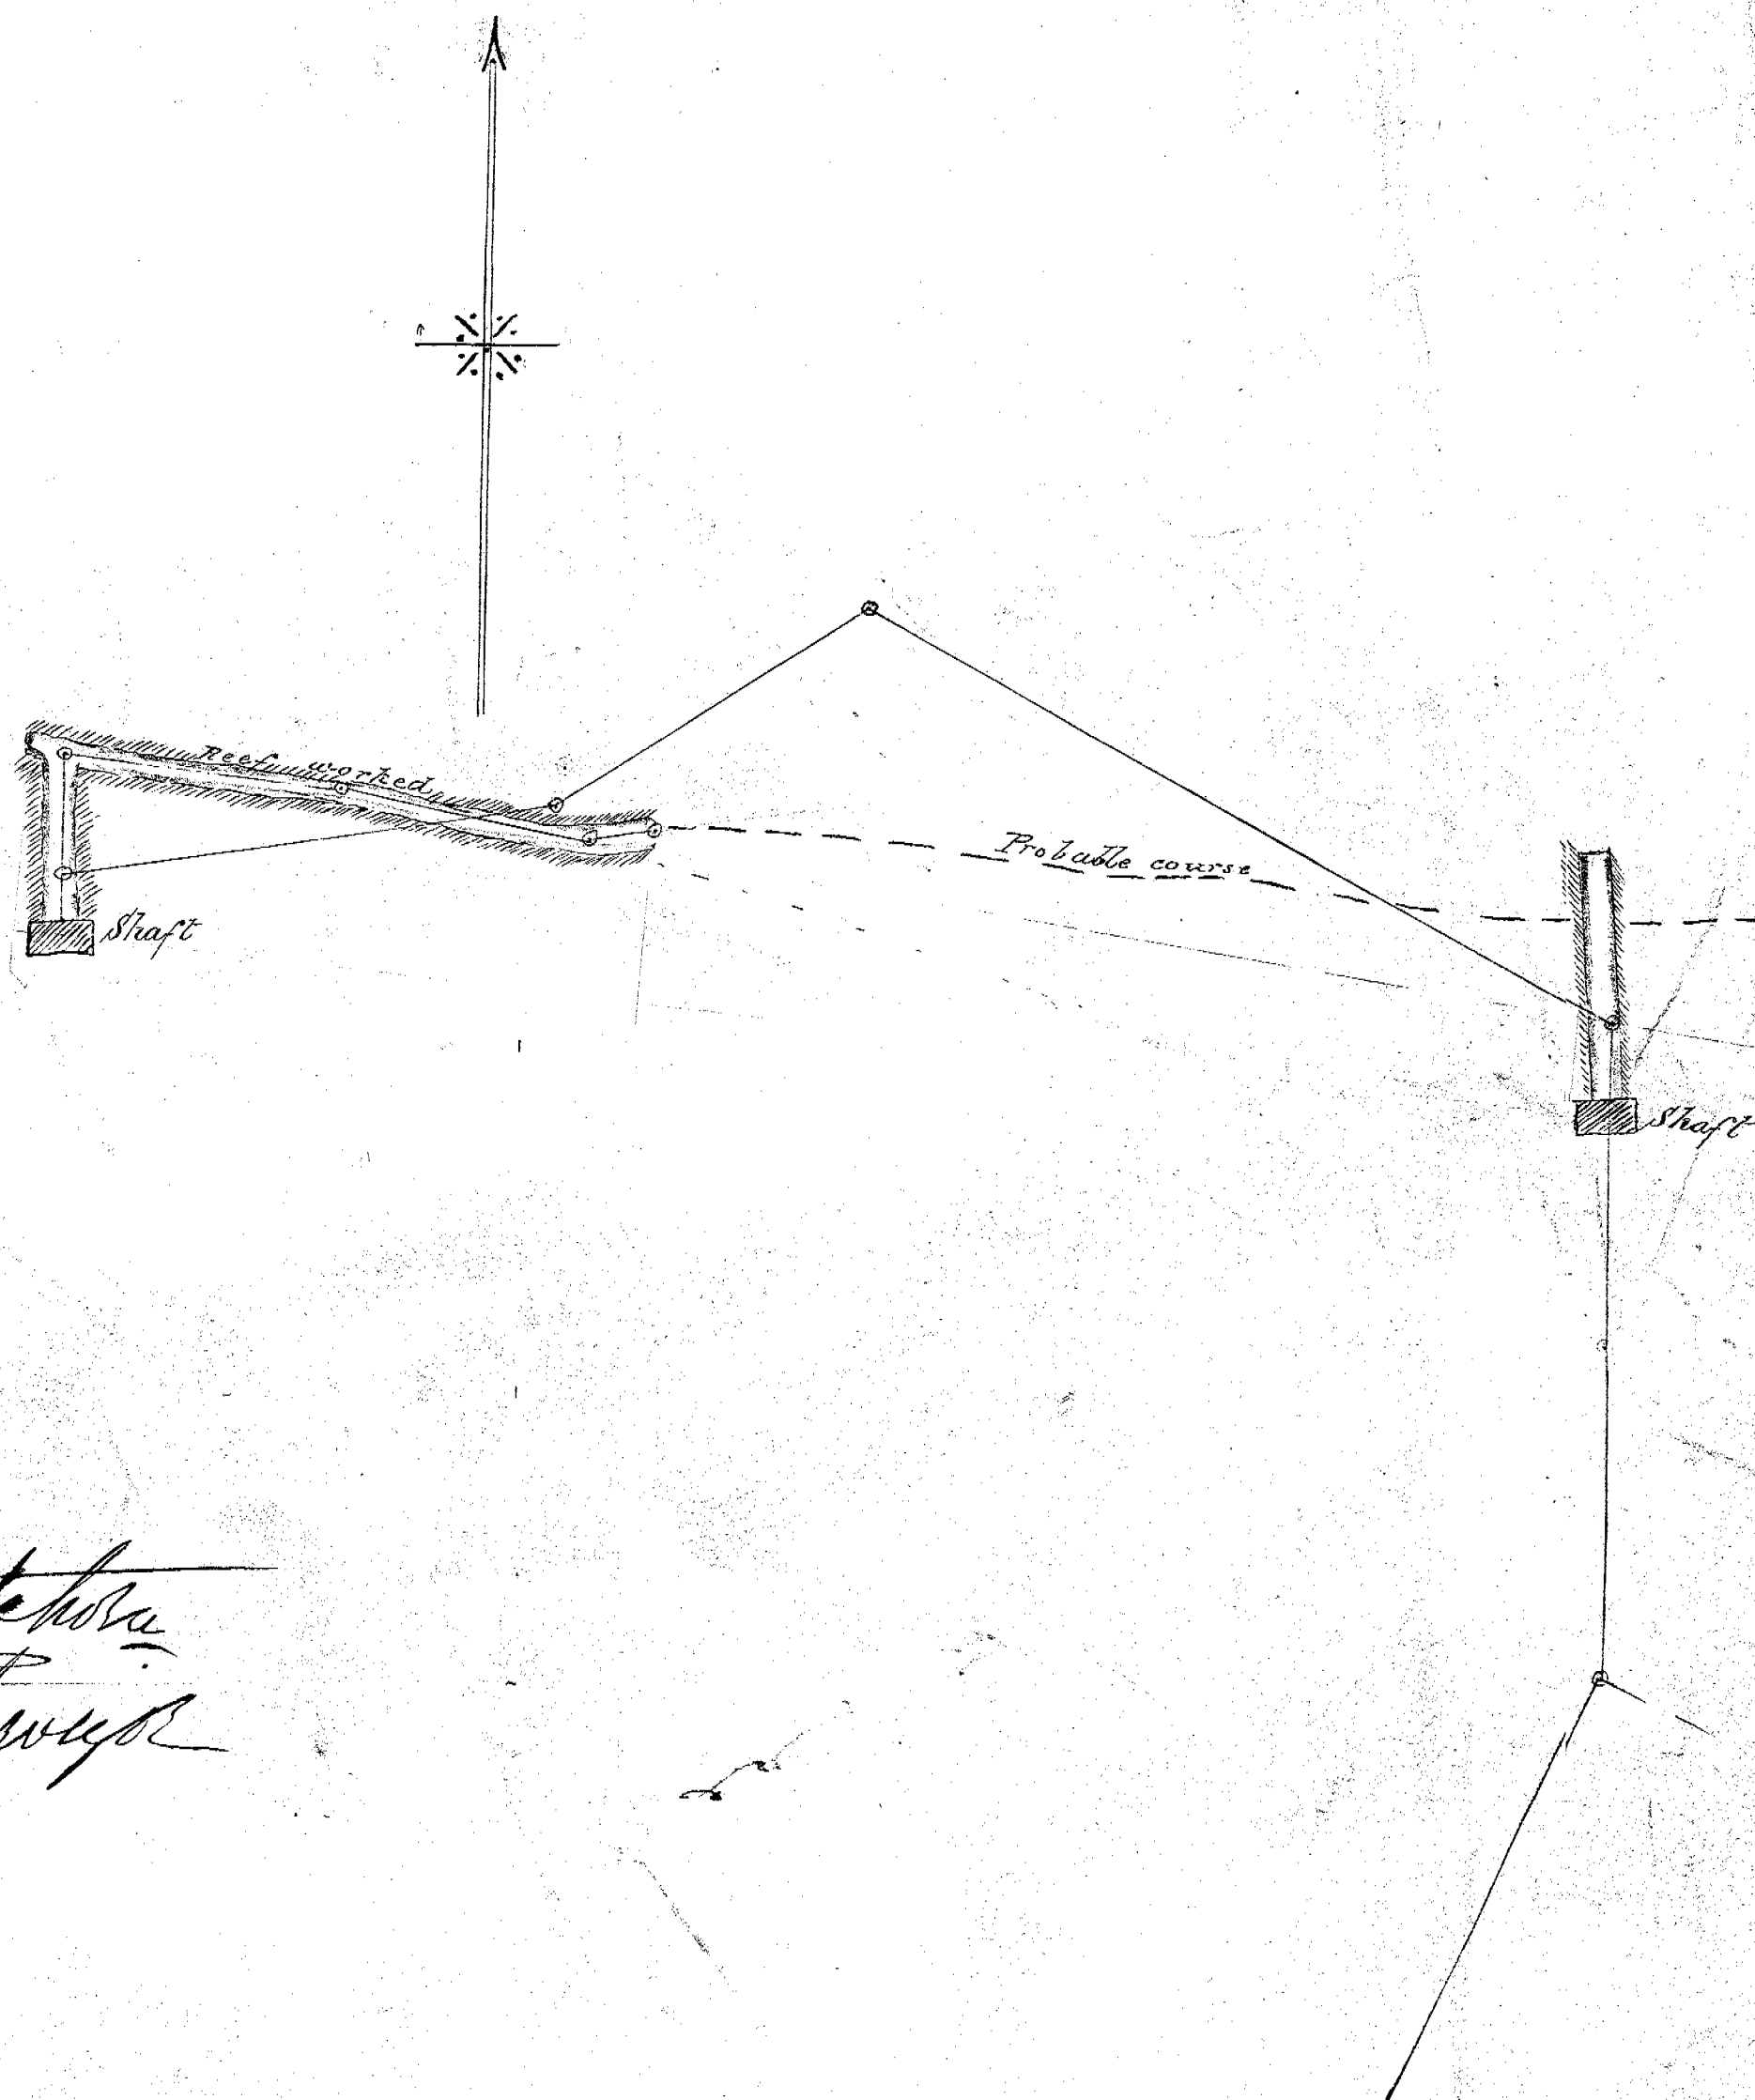

*C. Duff Waterhouse
Mining Survey
1884*