
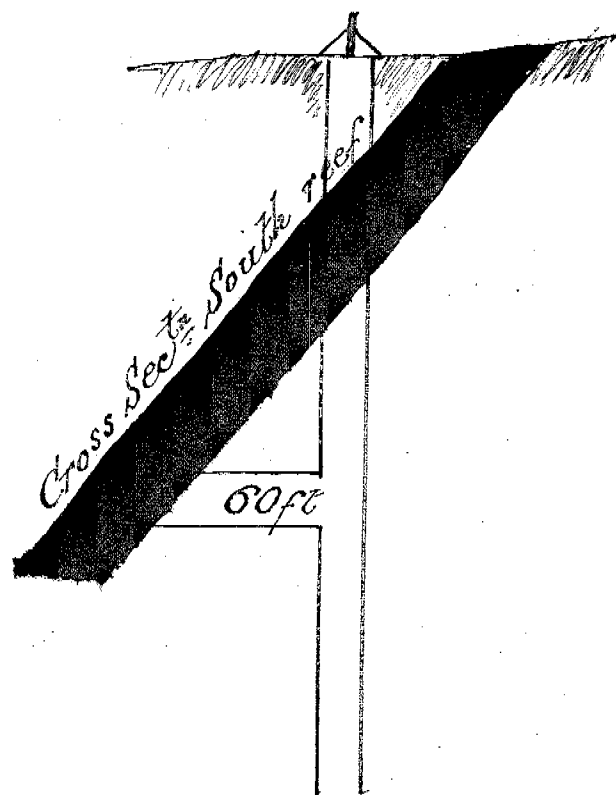


112-01

5 cm

MOONLIGHT C. M.

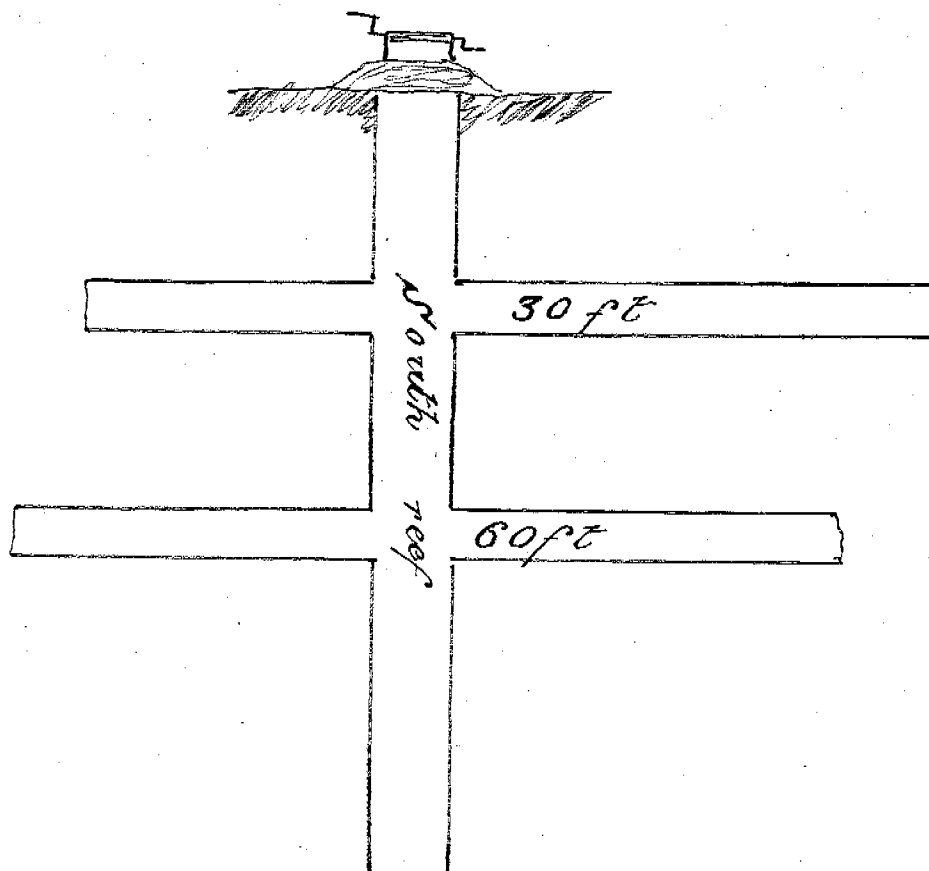

Certified correct copy
 of work done on South
 Reef in above mine
 during years 1890
 C. Douglas Watson
 Mining Supervisor