


5 cm

112-02

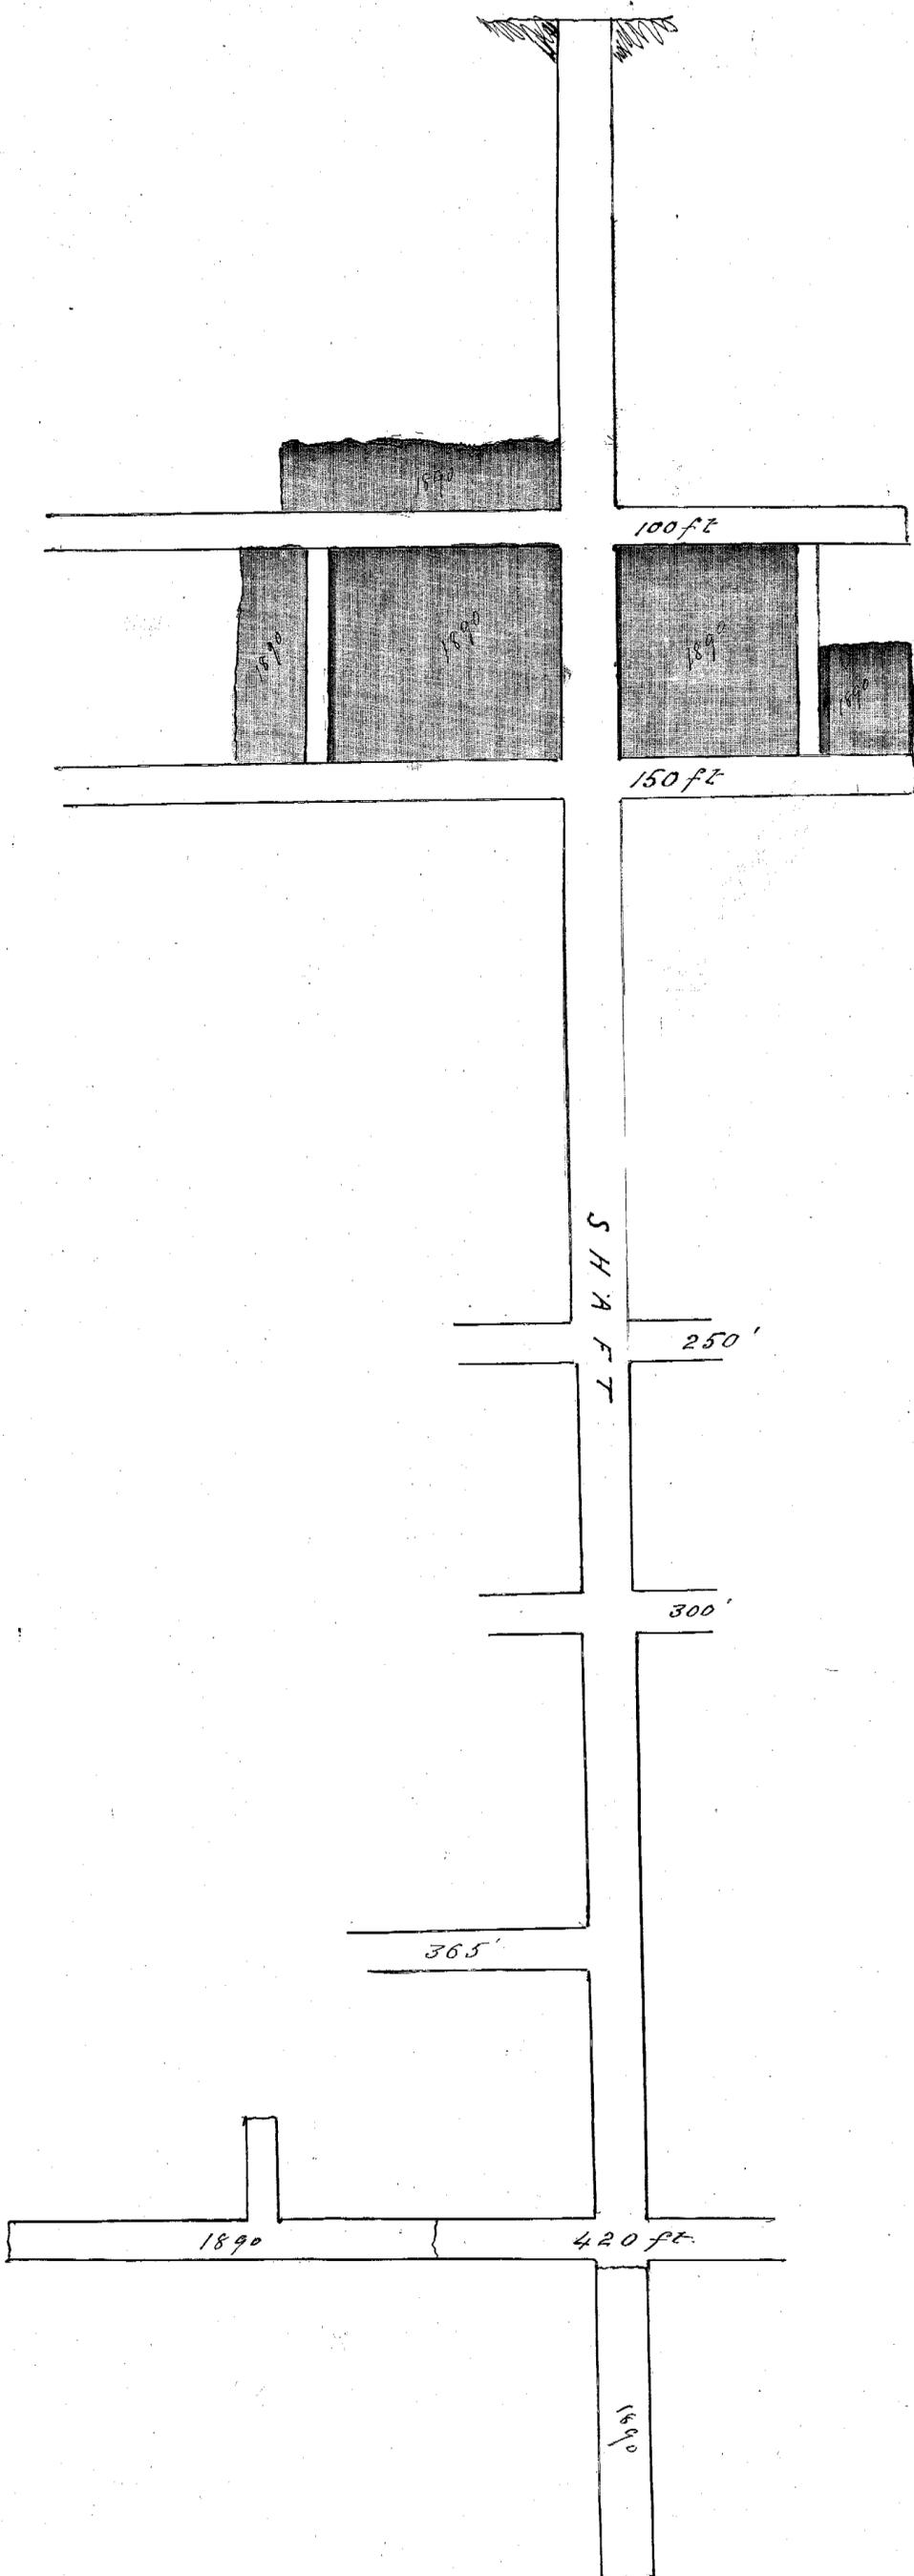

Certified correct copy  
 of above mine  
 to and of year 1890  
 by  
 Wm. H. Mather  
 Mining Surveyor