


Scale 4 inches to 100 feet.

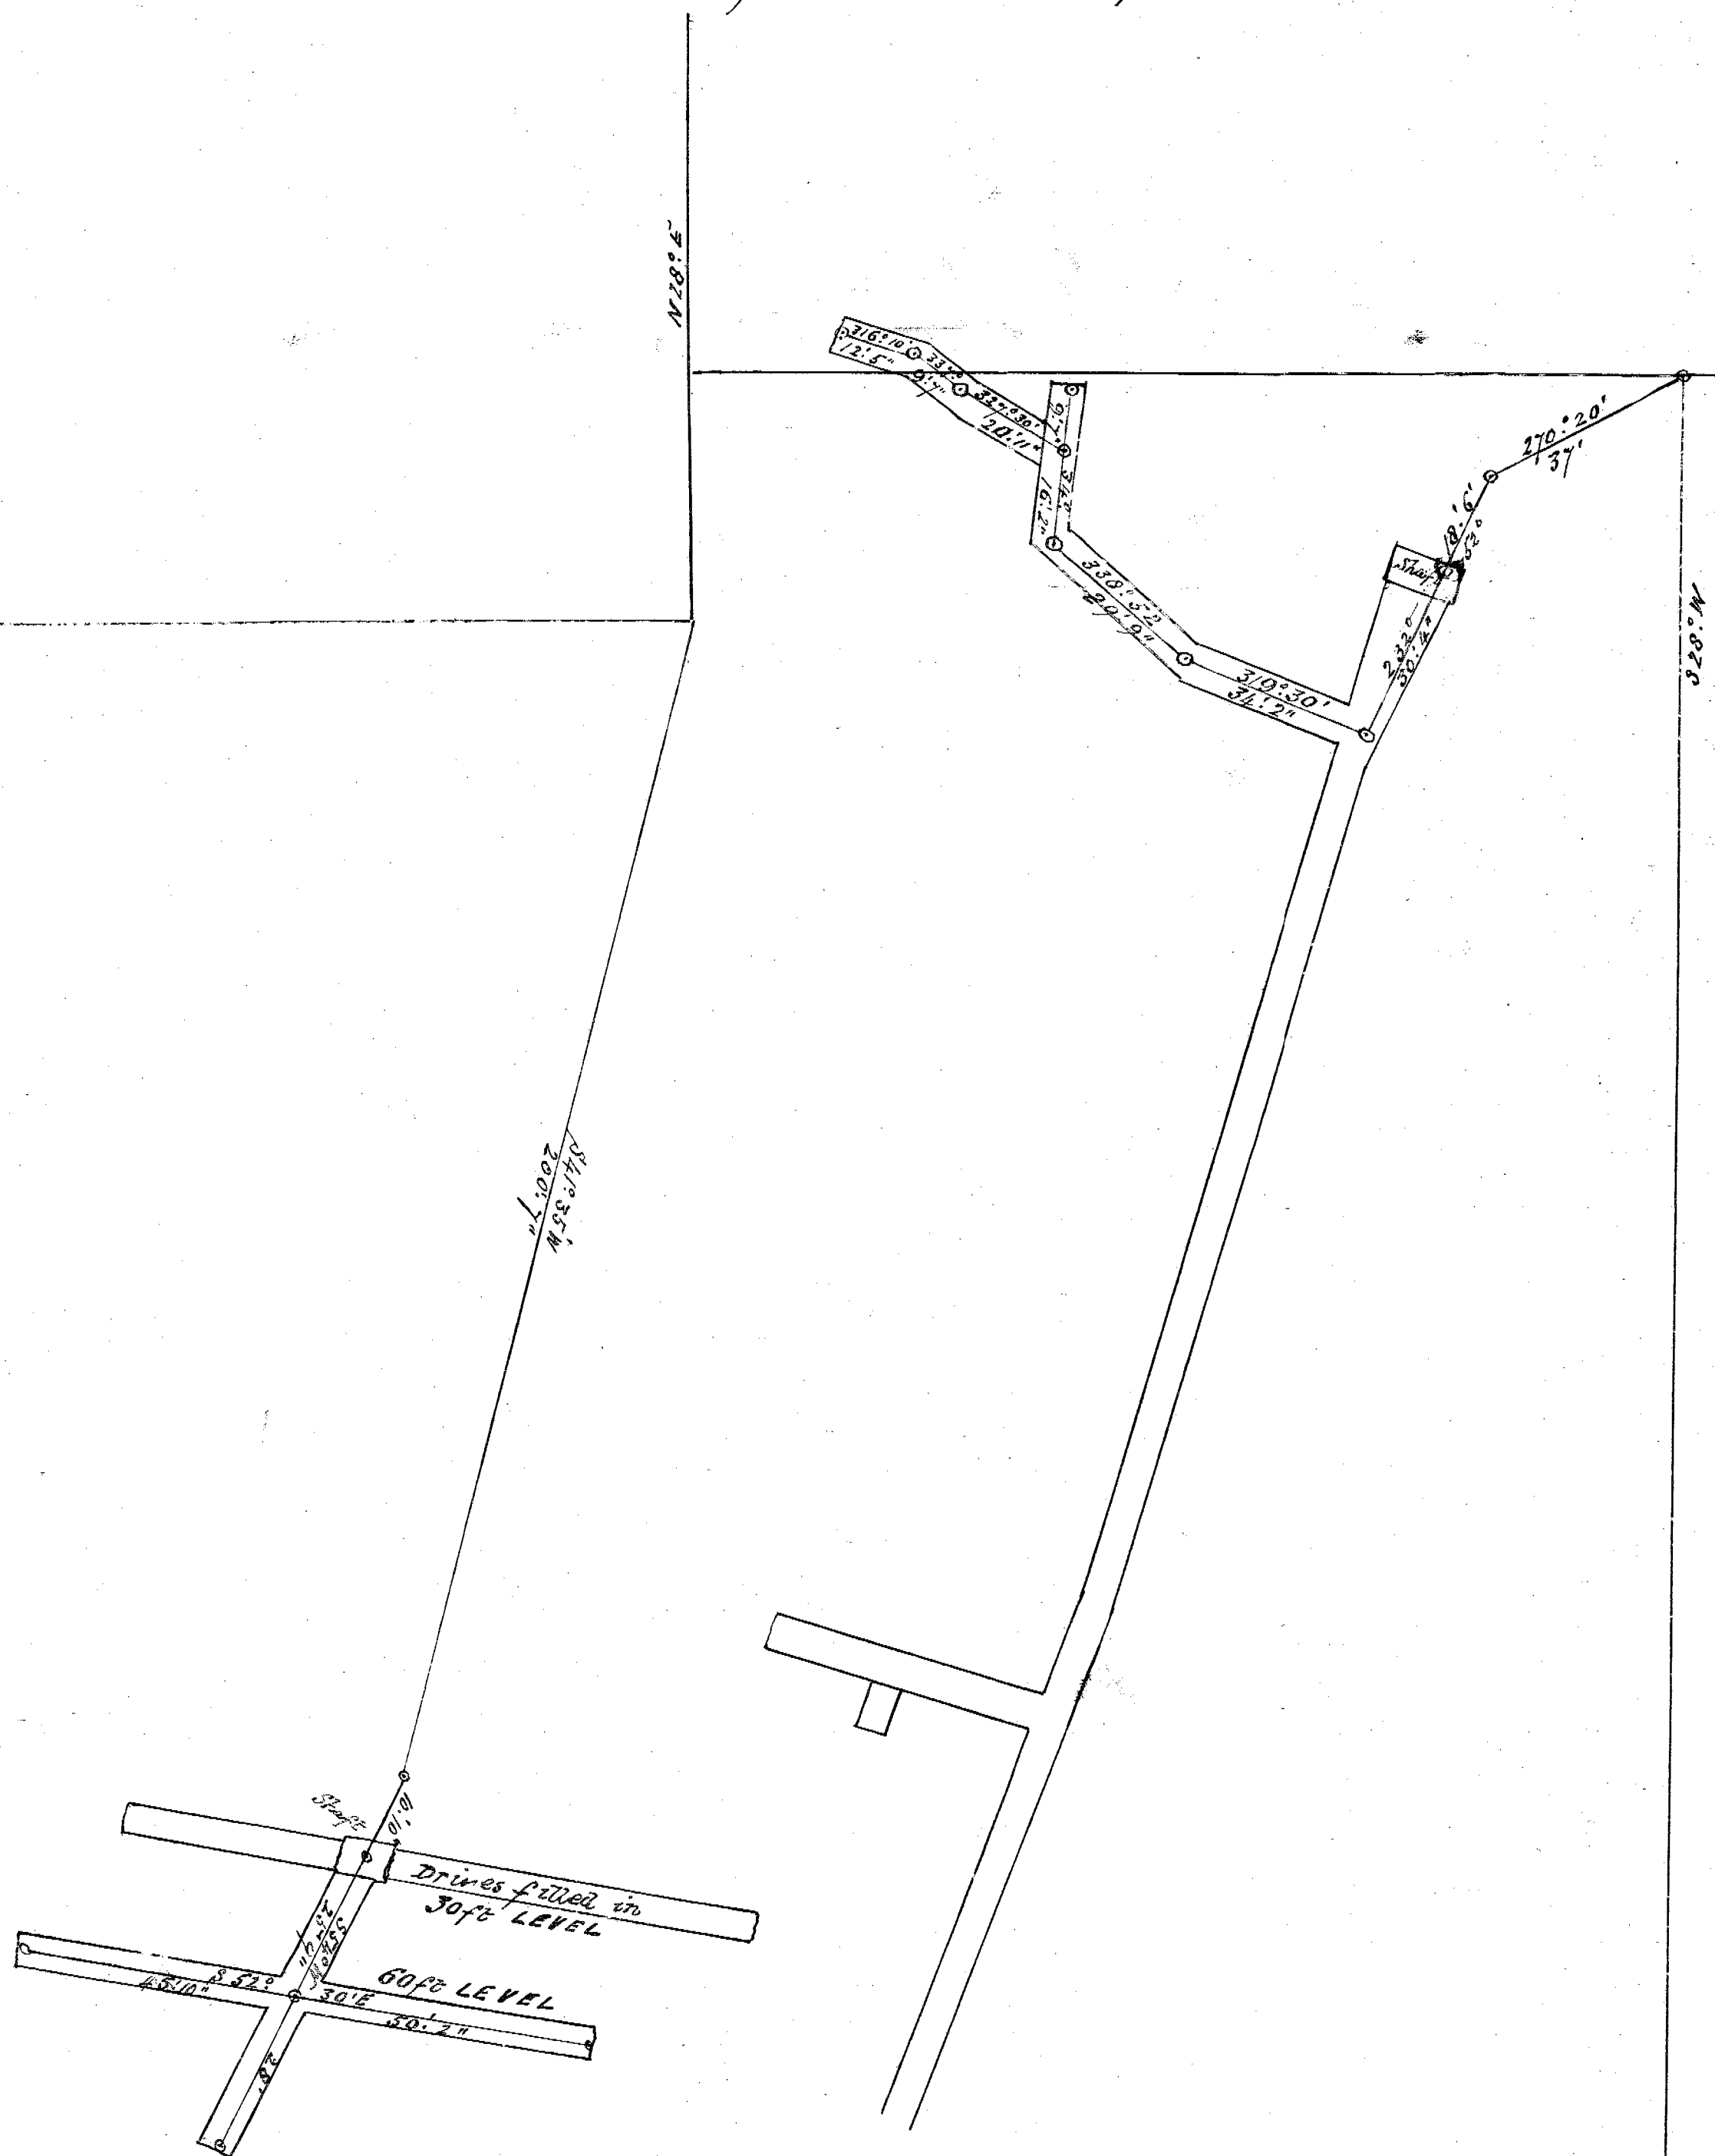

*Cashier correct copy
of working paper for a
year 1890.
Can be obtained during
the winter.*