


N^o 1.

OLIVE BRANCH GOLD MINING C^o

SURVEY PLAN of The Claim at BEACONSFIELD.

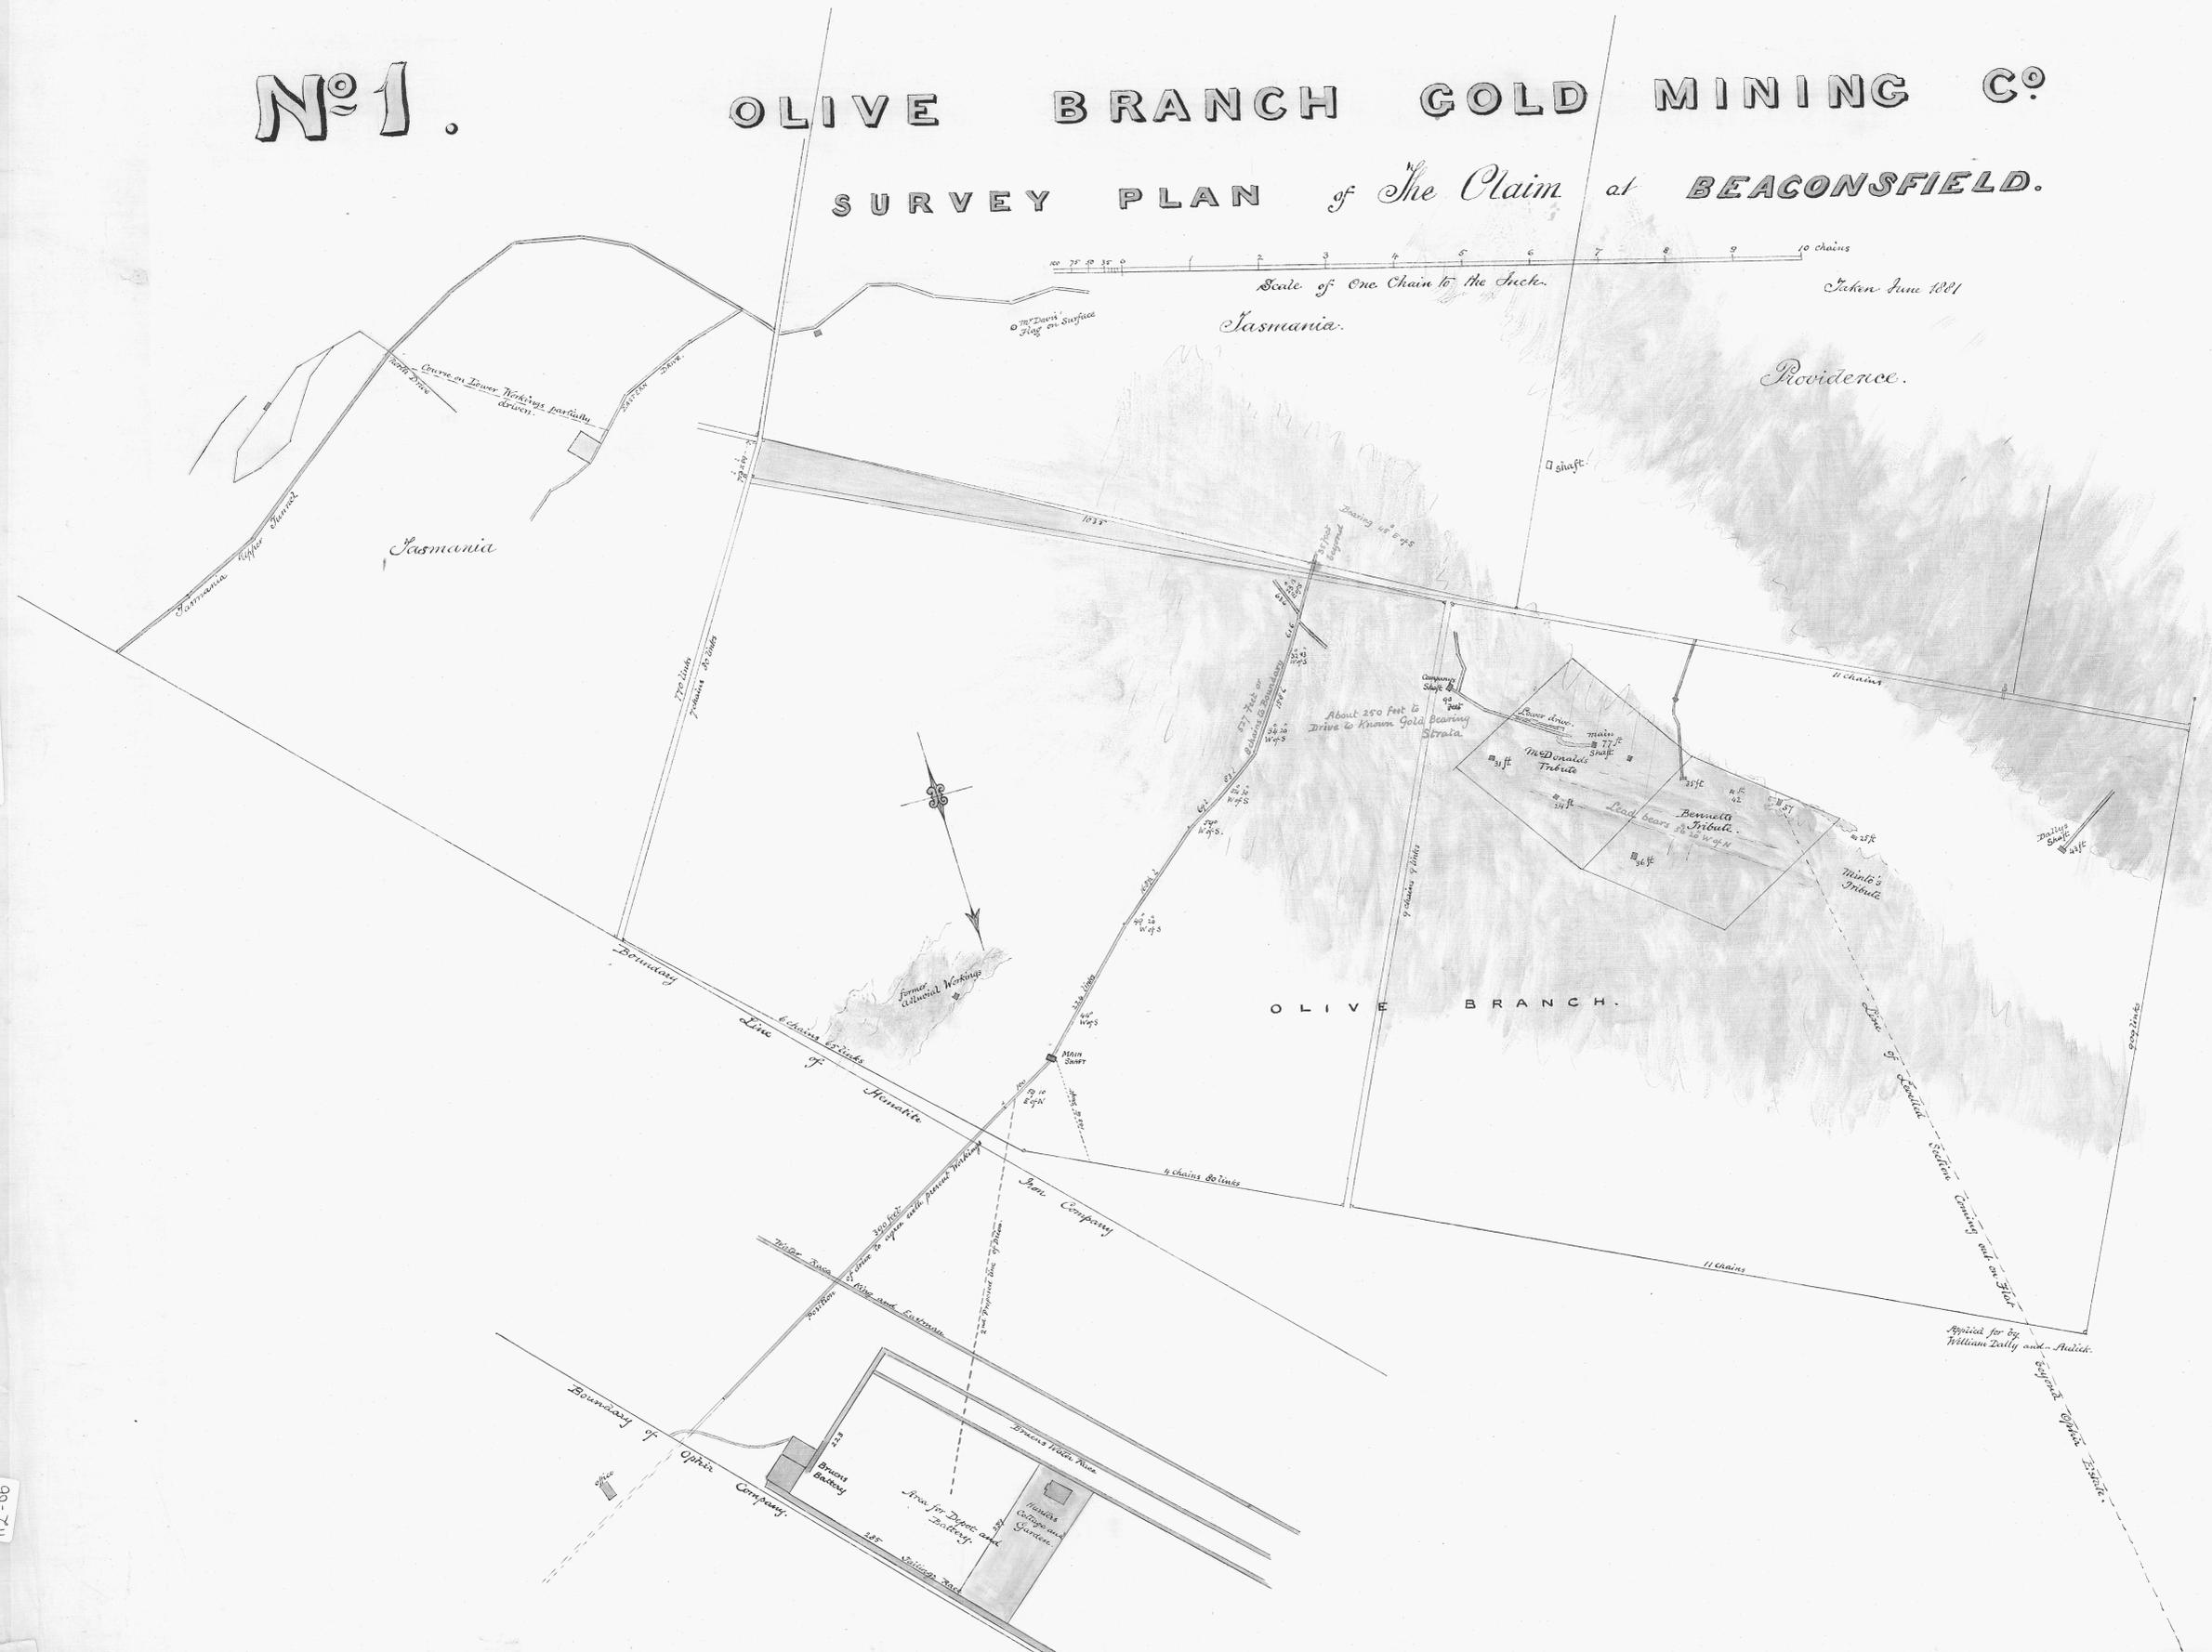

Scale of One Chain to the Inch.

Taken June 1881

Sasmania.

Providence.

Sasmania

OLIVE BRANCH.

Former Colonial Workings

McDonald's Trench

Barnetta's Trench

Mink's Trench

Main Shaft

Bruce's Battery

Plan for Depot and Battery

Applied for by William Dalry and Aulick

Signed Wm Dalry

112-06

5 cm

112-06

1

111